

KANSAS


Stafford

FORM 51 5M PETROL

Section 17 Township 22 Range 12 W

Well No. #2 Smith

Company Alpine Oil & Royalty & Phillips

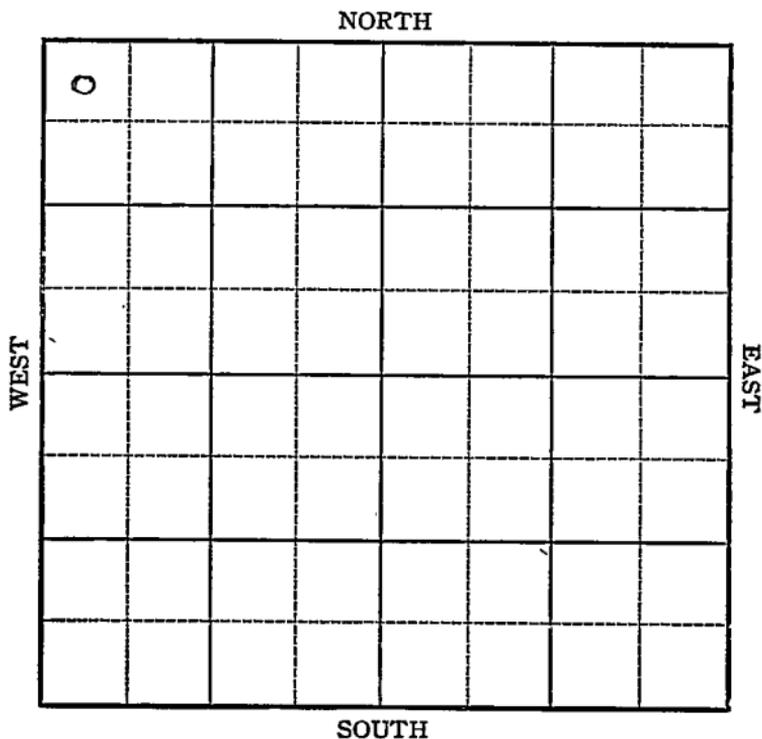


Sec. 17 Twp. 22 R. 12-W

Well No. #2 Smith Farm

Alpine Oil & Royalty & Phillip Company

NORTH

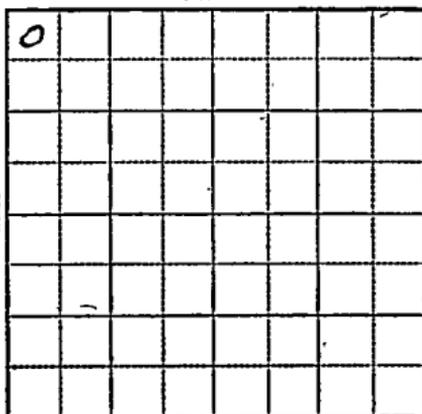

330 Ft. from N. Line

_____ Ft. from S. Line

_____ Ft. from E. Line

330 Ft. from W. Line

Elev. 1875

SOUTH

1943

R E P O R T

12/1 Rotary
12/8 Surface hole 150'
12-15 10" at 240'
Drlg. 2040'

12/22 Drlg. 3190'
12-29 TD 3726'
Lans 3343'
Viola 3609'
Simp 3639'
Arb 3696'

ABANDONED

Map No. 46 Sec. 17 Twp. 22 R. 12WWell No. 2 SmithAlpine Oil & Royalty & Phillips
Company

FIRST REPORT

Contractor

NW/C

SECTION PLAT

330 Ft. from N. Line

_____ Ft. from S. Line

_____ Ft. from E. Line

330 Ft. from W. Line

0			

Drach Pool

Location _____

Rig up _____

Drilling and Remarks:

Rotary

RECORD

Cased _____ in., _____ ft.

Sand _____

Gas _____

Oil _____

Total Depth _____

PRODUCTION

1st 24 hrs. Nat. _____

1st 24 hrs. after shot _____

Gas _____ Cu. Ft.

Dry Hole? _____

Abandoned _____

Date

DEC 1 1943 19S. J. LEWIS Scout

KANSAS

Map No. 46 Sec. 17 Twp. 22 R. 12WWell No. ? SmithAlpine Oil & Royalty & Phillips Company

ABANDONED

Contractor

NW/C

SECTION PLAT

330 Ft. from N. Line

_____ Ft. from S. Line

_____ Ft. from E. Line

330 Ft. from W. Line

o			

Drach Pool

Location _____

Rig up _____

Drilling and Remarks:

*Line 3343**Vid 3609**Sm 3639**Co 43696*

RECORD

Cased _____ in., _____ ft.

Sand _____

Gas _____

Oil _____

Total Depth 2726

PRODUCTION

1st 24 hrs. Nat. _____

1st 24 hrs. after shot _____

Gas _____ Cu. Ft.

Dry Hole _____

Abandoned _____

Date

DEC 29 1943 19

S. J. LEWIS Scout