

KANSAS


FORM 51 5M 1-42 PETROL

Stafford

Section 17 Township 22 Range 12W

Well No. #1 Smith

Company Alpine Oil & Royalty

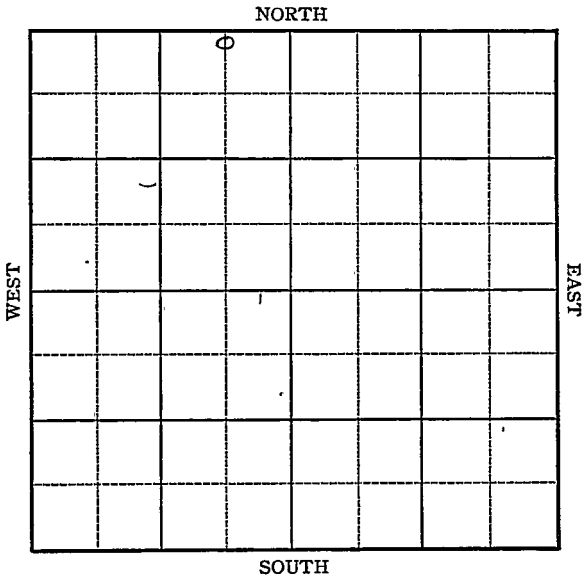

KANSAS

Stafford

Sec. 17 Twp. 22 R. 12-W

Well No. #1 Smith Farm

Alpine Oil & Royalty Company

Drach


330 Ft. from N. Line

 Ft. from S. Line

660 Ft. from E. Line

 Ft. from W. Line

Elev. 1878

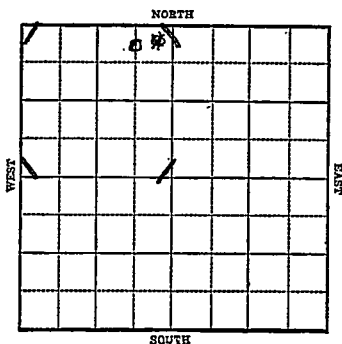

1943

R E P O R T

4/7 Location.

4/14 Rotary

4/21 8" @ 250'
Drlg. 2425'

4/28 Lans 3376'
Drlg. 3432'

5/5 Viola 3642
Arb. 3763
T.D. 3790'
No shows.

ABANDONED


Map No. 46 Sec. 17 Twp. 22 R. 12WWell No. 1 SmithAlpine Oil & Royalty Company**FIRST REPORT**

Contractor

C NL NE NW

330 Ft. from N. Line Ft. from S. Line660 Ft. from E. Line Ft. from W. Line

SECTION PLAT

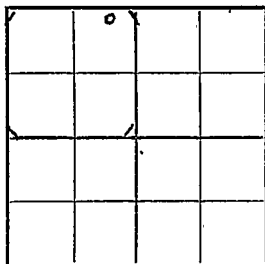

DRACH POOL

Location XXXRig up Drilling and Remarks:

RECORD

Cased in., ft.Sand Gas Oil Total Depth

PRODUCTION

1st 24 hrs. Nat. 1st 24 hrs. after shot Gas Cu. Ft.Dry Hole Abandoned

Date

APR 7 1943

19

S. J. LEWIS

Scout

KANSAS

Stafford

Map No. 46 Sec. 17 Twp. 22 R. 12WWell No. 1 Smith

Alpine Oil & Royalty Company

ABANDONED

Contractor

C NL NE NW

SECTION PLAT


330 Ft. from N. Line

Ft. from S. Line

660 Ft. from E. Line

Ft. from W. Line

DRACH P OOL

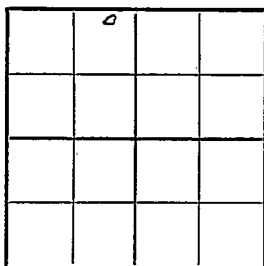

Location

Rig up

Drilling and Remarks:

*Vista 3642**Cr 43763**Noelows*

RECORD

Cased _____ in., _____ ft.

Sand _____

Gas _____

Oil _____

Total Depth 3280

PRODUCTION

1st 24 hrs. Nat. _____

1st 24 hrs. after shot _____

Gas _____ Cu. Ft.

Dry Hole _____

Abandoned _____

Date

MAY 5 1943 19

S. J. LEWIS Scout