

O. W. D. D

FORM 51 25M 8-50 WESTERN

Harvey KANSAS

Section 17 Township 22 Range 3 W

Well No. # 1 Kim

Company A. D. Allison
~~Gabbert & Jones~~

NORTH

				0			

WEST

EAST

SOUTH



Sec. 17 Twp. 22 R. 3W

Well No. #1 Kim Farm

A. D. Allison
Gabbert & Jones

Company

Contractor


330 Ft. from N. Line

Ft. from S. Line

Ft. from E. Line

455 Ft. from W. Line

NW NW SE

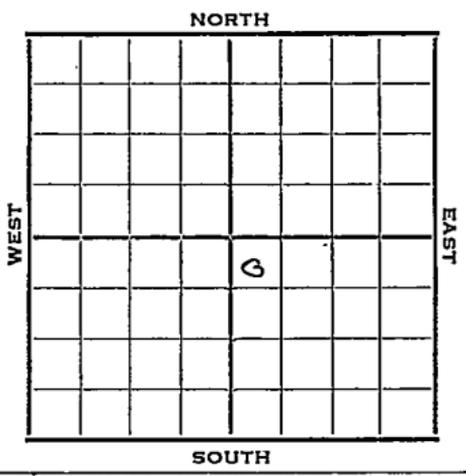

1952 Elev. 1453' REPORT

6/11 Spud 5-31-52
8" @ 272'
Drlg. 2393'

6/18 Miss 3169'
DST 3169-3203' 1 hr, 45' GCM
DST 3203-07

6/25 Spud 5-31-52
D&A TD 3533
8" @ 272
Miss 3169
DST 3169-3203 opn 1 hr. Rec. 45' gcm
DST 3207-14 opn 1 hr. Rec 60' so
& gcm Kh 3398 Hunton 3505
DST 3515-33 opn 1 hr. Rec. 12' socm
60' sw TD 3533
D&A **ABANDONED**

O. W. D. D

1952
11/5 Miss 3169' Kh. 3398' Hunton 3505'
OTD 3533' DD 3543' 5" @ 3543'

11/12 D & A - Hold

11/19 D&A
TD 3555'
Miss 3169, Kh. 3398, Hunton
3505,
OTD 3533

OVER

(Information Brought Forward)

1952
11/19

DD 3543 DD 3555

5" @ 3543

12/3527-31, 6/3524-26, 1 bwph

SP 3519, 16/3508-12, 3/4 bwph

6/3514-16 SO 6/3516-18

$\frac{1}{2}$ goph 1000A SO & 1 bwph

D&A

ABANDONED

County Harvey State Kansas

Sec. 17 (Blk. Twp.) 22 (Sur. Rge.) SW Map No.

Operator Gabbert & Jones

Well No. 1 Farm Kim

Elev. 1453 Location NW NW SE

330 Ft. From N Line SE

455 Ft. From W Line Quarter

Ist. Report JUN 11 1952

Completion _____

Remarks _____

Spudding Date 5-31-52

Drlg. Data _____

3" @ 272 Drlg. 2395

J. G. MCGEHEE

O. W. D. D


County **Harvey** State **Kansas**
 Sec. **17** (Blk. **22** (Sur. **3W** Map No.
 (Twp.) (Rge.)
 Operator **A. D. Allison** (~~was Gabbert-Jones~~)
 Well No. **1** Farm **Kim**
 Elev. **1453** Location **NW NW SE**

330 Ft. From **N** Line **SE**
455 Ft. From **W** Line **Quarter**
 Ist. Report **NOV 5 1952**
 Completion **O. W. D. D**
 Remarks
 Spudding Date

FIRST REPORT

Drlg. Data
Miss. 3169 Kh. 3398 Hunton 3505
OTD 3533 DD 3543 5" @ 3543

County Harvey State Kansas
 Sec. 17 (Blk. 22 (Sur. 3W Map No. (Twp.))
 Operator A. D. Allison (was Gabbert-Jones)
 Well No. 1 Farm Kim
 Elev. 1453 Location NW NW SE

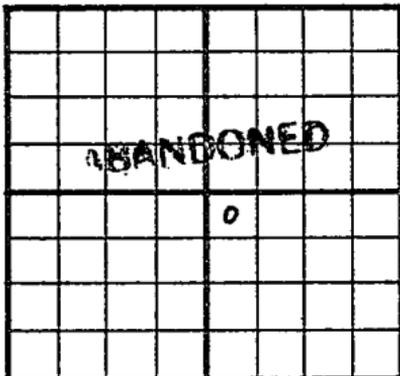

330 Ft. From N Line SE
455 Ft. From W Line Quarter
 Ist. Report _____
 Completion NOV 19 1952
 Remarks OWWO
 Spudding Date _____

Drig. Data D & A TD 3555
Miss. 3169 Kh. 3398 Hunton 3505
OTD 3533 DD 3543 DD 3555 5" @ 3543
12/ 3527-31 6/ 3524-26 1 bwph SP 3519
16/ 3508-12 3/4 bwph 6/ 3514-16 SO
6/ 3516-18 1/2 goph 1000 A SO & 1 bwph
D & A