FORM 51 10M 2-49 PETROL

Harvey

KANSAS

Section 17 Township 22 Range 3W

Well No. #1 Friessen

Company Coppinger & Southern

Hollow & Nickle

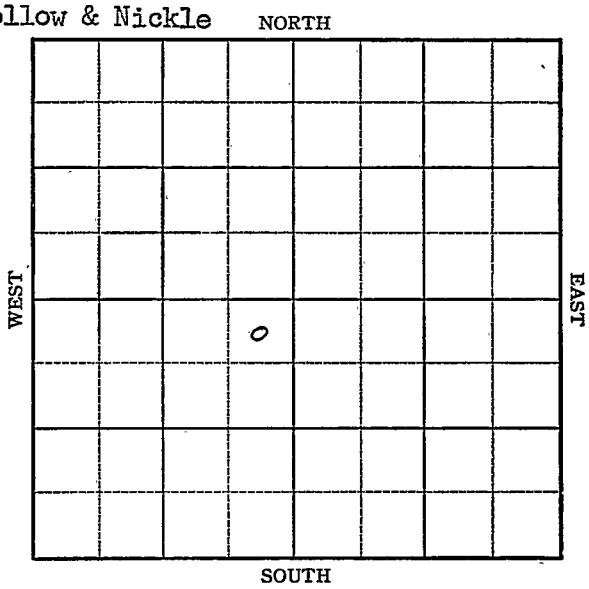

FORM 252-B
10M 9-49 PETROL

KANSAS Harvey

Sec. 17 Twp. 22 R. 3W

Well No. #1-- Friessen -- Farm

Coppinger & Southern Company

Coppinger & Southern, Contr. Contractor

Hollow & Nickel

330' Ft. from N. Line

Ft. from S. Line

330' Ft. from E. Line

Ft. from W. Line

NE SW

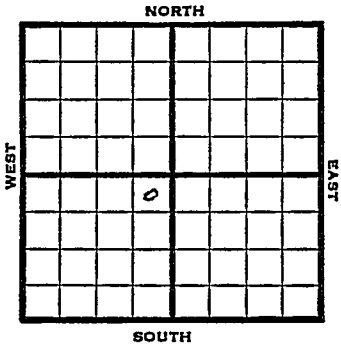

1949	Elev. 1462' REPORT
12/14	8" @ 342' Drlg. 568'
12/21	KC 2485' Miss 3165' Hunton 3440' TD 3494' 5" @ 3489'
12/28	"
1950	
2/22	8" @ 342' 5" @ 3489' KC 2485' Miss 3165' Hunton 3440' 25 BOPD, 70% wtr TD 3535' COMPLETED

Form 26 200 Bks. 6-49 Petrol

Kansas

Hollow & Nickle

Map No. _____ Sec. 17 Twp. 22 R. 3W

Well No. 1 Friessen

Coppinger & Southern Company

Coppinger & Southern Contractor

NE SW

FIRST REPORT

SECTION PLAT

330 Ft. from N. Line

_____ Ft. from S. Line

330 Ft. from E. Line

_____ Ft. from W. Line

Harvey County

Location _____

Rig up _____

Drilling and Remarks:

8" @ 342

drlg. 568

RECORD

Cased _____ in., _____ ft.

Sand _____

Gas _____

Oil _____

Total Depth _____

PRODUCTION

1st 24 hrs. Nat. _____

1st 24 hrs. after shot _____

Gas _____ Cu. Ft.

Dry Hole _____

Abandoned _____

Date

DEC 14 1949 19

S. I. LEWIS Scout

Form 26 200 Bks. 11-49 Petrol Kansas

Hollow & Nickles

Map No. _____ Sec. 17 Twp. 22 R. 3W

Well No. 1 Friessen

Coppinger & Southern Company

Contractor

NE SW

El. 1462

SECTION PLAT

330 Ft. from N. Line

Ft. from S. Line

330 Ft. from E. Line

Ft. from W. Line

COMPLETE

Harvey County

Location

Rig up

Drilling and Remarks:

8" @ 342

5" @ 3489

K.C. 2485

Miss 3165

Hunton 3440

25 BOPD

70% water

RECORD

Cased _____ in., _____ ft.

Sand

Gas

Oil

Total Depth 3535

PRODUCTION

1st 24 hrs. Nat.

1st 24 hrs. after shot

Gas _____ Cu. Ft.

Dry Hole

Abandoned

Date

FEB 22 1950 19

J. E. TYRA Scout