

Harvey

Section 17 Township 22 Range 3W

Well No. #2 Rupp

Company A. D. Allenson

NORTH

			6				

WEST

EAST

SOUTH

Sec. 17 Twp. 22 R. 3 W

Well No. # 2 Rupp Farm

A. D. Alleson Company

Contractor


990 Ft. from N. Line

Ft. from S. Line

330 Ft. from E. Line

Ft. from W. Line

SE NE NW

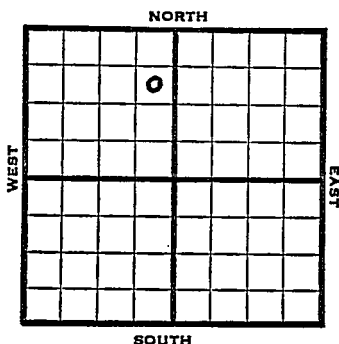

1952

Elev. 1462 REPORT

8/13 Spud 8-2-52
8" @ 320
Drlg. 2810'

8/20 Shut down 3340

8/27 Miss. 3159 Meisner 3446
Htn. 3450
TD 3453' 5" @ 3451'

9/3 DD 3467 wtr PB 3453 500 A
Fill up 400' wtr & 1 BO 24 hrs.

9/10 DD 3520 2000 A wtr.

9/17 NR

9/24 D&A TD 3520 8" @ 320
Miss 3159 Misener 3446
Hunton 3450 TD 3453
5" @ 3451 DD 3467 wtr.
PB 3463 500 A FU 400' wtr.
1 bo 14 hr. DD 3520 2000 A
wtr D&A

ABANDONED

County Harvey State Kansas

Sec. 17 (Blk. Twp.) 22 (Sur. Rge.) 3W Map No.

Operator A. D. Allison

Well No. 2 Farm Rupp

Elev. Location SE NE NW

990 Ft. From N Line NW

330 Ft. From E Line Quarter

1st. Report AUG 13 1952

Completion _____

Remarks _____

Spudding Date 8-2-52

Drlg. Data _____

8" @ 320 Drlg. 2810

J. G. McGEHEE

County Harvey State Kansas

Sec. 17 (Blk. Twp.) 22 (Sur. Rge.) 3W Map No.

Operator A. D. Allison

Well No. 2 Farm Rupp

Elev. 1462 Location SE NE NW

		0			

990 Ft. From N Line NW

330 Ft. From E Line Quarter

1st. Report

Completion SEP 24 1952

Remarks

Spudding Date 8-2-52

Drig. Data D & A TD 3520

8" @ 320 Miss. 3159 Misener 3446

Hunton 3450 TD 3453 5" @ 3451

DD 3467 wtr. PB 3463 500 A

FU 400' wtr. 1 bo 14 hr. DD 3520

2000 A wtr.

D & A