



Map No. \_\_\_\_\_ Sec. 17 Twp. 22 R. 3W

Well No. 3 Schmidt Farm


Hollow et al Company

990 Ft. from N. Line

\_\_\_\_\_ Ft. from S. Line

990 Ft. from E. Line

\_\_\_\_\_ Ft. from W. Line

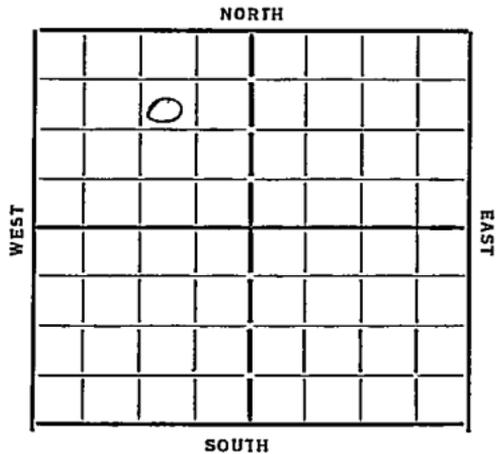

Date	REPORT
1933	
8/9	Cellar
8/17	Rig
8/23	12" 288 L.O.O.
8/30	Wrlg 2405
9/6	Top chat 3160 wreg 3240
9/13	B.L. 3314 - cum 7" 3405 - RLST
9/20	Bailing mud
9/29	TD 3449 swab 84 bbls 4 hrs run tubing
10/5	Top Chat Acidized no test
10/11	Hunton 3415
	T. D. 3449
	1000 gallon acid
	30 bbls per hour
	COMPLETED OWD
1934	
5/9	OTD 3452 10 Bbls per hr.
	dly to 3482 TD 70 Bbls per hr.
	FIRST REPORTS
	✓
	COMPLETED

Map No. 43 Sec. 17 Twp. 22 R. 3W

Well No. 3-Schmidt

Hollow et al Company

Contractor

# SPECIAL

## SECTION PLAT

990 Ft. from N. Line

..... Ft. from S. Line

990 Ft. from E. Line

..... Ft. from W. Line

## FIRST REPORTS

	o		

Location.....

Rig up.....

Drilling and Remarks:

*collar*

### RECORD

Cased..... in., ..... ft.

Sand.....

Gas.....

Oil.....

Total Depth.....

### PRODUCTION

1st 24 hrs. Nat.....

1st 24 hrs. after shot.....

Gas..... Cu. Ft.

Dry Hole.....

Abandoned.....

Date

*8/9/33*

192

*O. Manschuet* Scout

Map No. 43 Sec. 17 Twp. 22 R. 3W

Well No. 3-Schmidt

Hallow et al Company

Contractor

SECTION PLAT

990 Ft. from N. Line

..... Ft. from S. Line

990 Ft. from E. Line

..... Ft. from W. Line

	0		

**COMPLETED**

Location.....

Rig up.....

Drilling and Remarks:

1000 gal acid

30 lbs per hr.

RECORD

Cased..... in., ..... ft.

Sand Huron 3415

Gas.....

Oil.....

Total Depth 3449

PRODUCTION

1st 24 hrs. Nat.....

1st 24 hrs. after shot.....

Gas..... Cu. Ft.

Dry Hole.....

Abandoned.....

Date

10-11-33 192

O. Mannick Scout

Map No. 43 Sec. 17 Twp. 22 R. 3W

Well No. 3-Schmidt  
Hollow etal Company

Contractor

**FIRST REPORTS**

**COMPLETED**

990 Ft. from N. Line

\_\_\_\_\_ Ft. from S. Line

990 Ft. from E. Line

\_\_\_\_\_ Ft. from W. Line

QWPO

**SECTION PLAT**

	0		

Location \_\_\_\_\_

Rig up \_\_\_\_\_

Drilling and Remarks:

OTD 3452  
10 bbls per hr.

Req to 3482

20 bbls per hr

**RECORD**

Cased \_\_\_\_\_ in., \_\_\_\_\_ ft.

Sand \_\_\_\_\_

Gas \_\_\_\_\_

Oil \_\_\_\_\_

Total Depth 3482

**PRODUCTION**

1st 24 hrs. Nat. \_\_\_\_\_

1st 24 hrs. after shot \_\_\_\_\_

Gas \_\_\_\_\_ Cu. Ft.

Dry Hole \_\_\_\_\_

Abandoned \_\_\_\_\_

Date

5-9-34 19

**ORVAL MANNSCHRECK**

Scout