

Harvey

Form 252-A
5M 4-32 MPC

KANSAS

Map No. _____ Sec. 17 Twp. 22 R. 3^W

Well No. 1-Schmidt Farm


SKelly-Selby Company

_____ Ft. from N. Line

330 Ft. from S. Line

_____ Ft. from E. Line

330 Ft. from W. Line

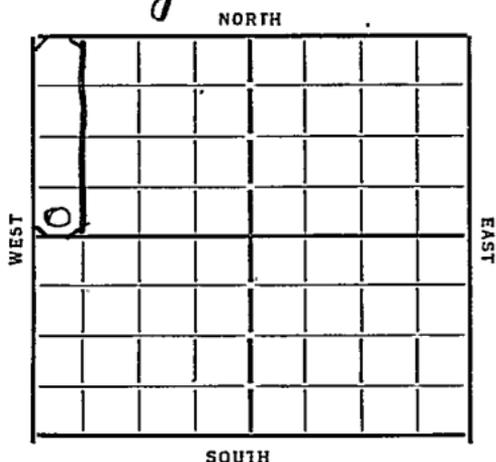

Date 1933

REPORT

OWDD

3/15 R. O. G.

3/22 Reconn-up

3/29 spud.

4/4 drlg 2200'

4/12 Top Chat 3143' run. 8" 3153'

4/19 drlg 3297'

4/26 Base line 3322 Henton 3427-28

drlg.

5/4 pulled 6" & run 5" casing

5/10 Top Henton 3431 fls full oil 3432-43

no test

5/17 Henton 3431-55 - T.D.

Pay 3438-43 Flow 1070 bbls

12 1/2 hrs with gun from Chat

Completed

1934

OWDD

6/20 OTD 3455 B.H. 3467

T.D. 3495 Tubing to acidize

6/28 1000 acid

7/5 —

7/11 Base Henton 3467 T.D. 3496

1000 acid 335 bbls.

COMPLETED

Harvey

43 KANSAS

Map No. Sec. 17 Twp. 22 R. 3^W

Well No. 1 Schmier

Kelly & Selby Company

Contractor

FIRST REPORTS

..... Ft. from N. Line


330 Ft. from S. Line

..... Ft. from E. Line

330 Ft. from W. Line

Oil lease
NW¹ NW² SE⁴ 7.

SECTION PLAT

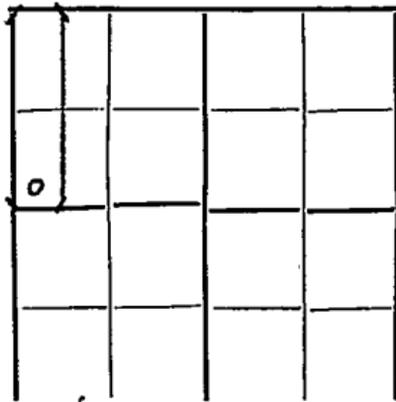

Location.....

Rig up.....

Drilling and Remarks:

R.O.S.

RECORD

Cased..... in., ft.

Sand.....

Gas.....

Oil.....

Total Depth.....

PRODUCTION

1st 24 hrs. Nat.....

1st 24 hrs. after shot.....

Gas.....:Cu. Ft.

Dry Hole.....

Abandoned.....

Date

MAR 15 1933

192.....

CHAS. L. SHERWOOD

Scout

Harvey

43 KANSAS Map No. Sec. 17 Twp. 22 R. 3^W

Well No. 1 Schmiat

Kelly & Selby Company

Contractor

COMPLETED

SECTION PLAT

.....Ft. from N. Line

330 Ft. from S. Line

.....Ft. from E. Line

330 Ft. from W. Line

0			
	5		

Location.....

Rig up.....

Drilling and Remarks:

Pay 3438-43
Flow 1070 Bbl
12 1/2 Hours With
Chat gas

RECORD

Cased in., ft.

Sand Huntan 3 1/4 31-55

Gas.....

Oil.....

Total Depth 3455

PRODUCTION

1st 24 hrs. Nat.....

1st 24 hrs. after shot.....

Gas..... Cu. Ft.

Dry Hole.....

Abandoned.....

Date

MAY 17 1933

CHAS. L. SHERWOOD

192..... Scout

Map No. 43 Sec. 17 Twp. 27 R. 3 W

Well No. 1 - Schmidt

Spelley & Selby Company
Contractor

FIRST REPORT SECTION PLAT

_____ Ft. from N. Line

330 Ft. from S. Line

_____ Ft. from E. Line

330 Ft. from W. Line

QWSB

Location _____

Rig up _____

Drilling and Remarks:

OTD 3455

B.H. 3467

TO 3495

*tubing to
analyzer*

RECORD

Cased _____ in., _____ ft.

Sand _____

Gas _____

Oil _____

Total Depth _____

PRODUCTION

1st 24 hrs. Nat. _____

1st 24 hrs. after shot _____

Gas _____ Cu. Ft.

Dry Hole _____

Abandoned _____

Date

6-20-34 19

ORVAL MANNSCHRECK

Scout

Map No. 43 Sec. 17 Twp. 22 R. 32

Well No. 1 - Schmidt

Spelly Oil Company

Contractor

COMPLETED

SECTION PLAT

 Ft. from N. Line
330 Ft. from S. Line
 Ft. from E. Line
330 Ft. from W. Line

0			

QWSD

Location _____

Rig up _____

Drilling and Remarks:

1000 acid:

335 lbs

RECORD

Cased _____ in., _____ ft.

Sand Base Benton 3467

Gas _____

Oil _____

Total Depth 3496

PRODUCTION

1st 24 hrs. Nat. _____

1st 24 hrs. after shot _____

Gas _____ Cu. Ft.

Dry Hole _____

Abandoned _____

Date

7-11-37 19

Scout