

KANSAS

(Harvey)


Form 51-5M-11-31-Palace

Map No. \_\_\_\_\_ Sec. 17 Twp. 22 R. 3W

Well No. 1 Schmidt Farm

Derby Oil Co. Company

NORTH

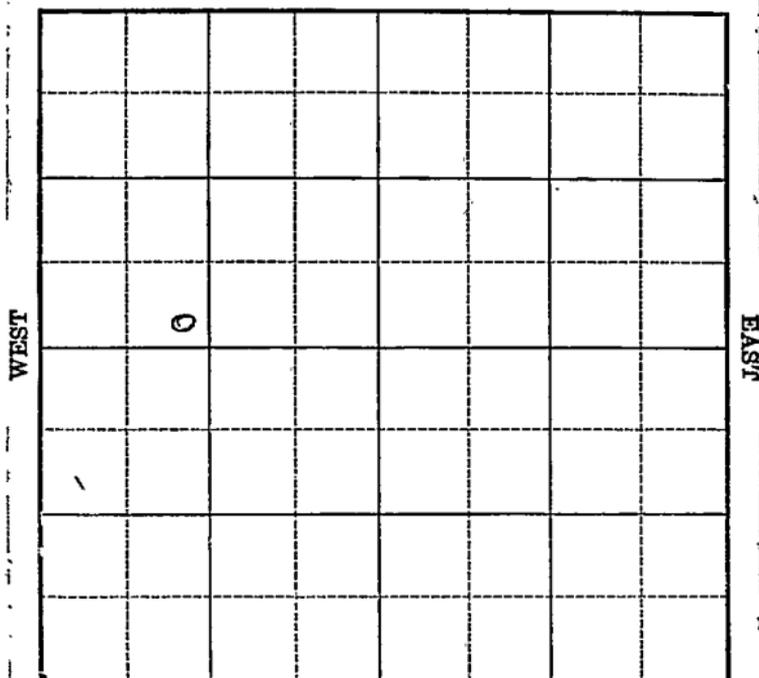

SOUTH

Location \_\_\_\_\_

Drilling Remarks \_\_\_\_\_

\_\_\_\_\_

\_\_\_\_\_

RECORD

Cased \_\_\_\_\_ in. \_\_\_\_\_ ft.

Sand \_\_\_\_\_

Gas \_\_\_\_\_

Oil \_\_\_\_\_

Total Depth \_\_\_\_\_

Rig Up \_\_\_\_\_

Drilling Remarks \_\_\_\_\_

\_\_\_\_\_

\_\_\_\_\_

PRODUCTION

1st 24 hrs. Nat. \_\_\_\_\_

1st 24 hrs. after shot \_\_\_\_\_

Gas \_\_\_\_\_ cu. ft.

Dry Hole \_\_\_\_\_

Abandoned \_\_\_\_\_

Map No. **KANSAS** Sec. 17 Twp 22 R. 3<sup>w</sup>

Well No. #1-Schmidt Farm

Herby Oil Co Company


\_\_\_\_\_ Ft. from N. Line

330 Ft. from S. Line

\_\_\_\_\_ Ft. from E. Line

990 Ft. from W. Line

1933

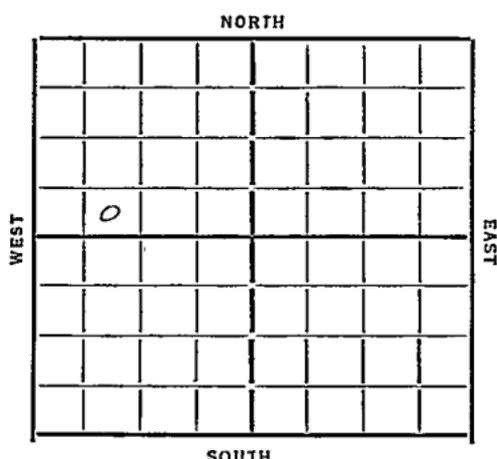

Date

REPORT

2/22	Bldg Rig
3/4	Rig
3/8	12" 287-1000 425'
3/15	1000 2147'
3/22	Chat 3161 cement 8" 3165-1000 6
3/24	J.D. 3342 Ent 40' Agar flow 10 bbls per hr. 900 <sup>+</sup> B.P.
4/4	B.L. 3361 Core 3425-35-6" 3434 Rest 3435
4/12	6" 3434' Sand 3442-3460 1/2 J.D. 3460 1/2 Swab 1568 bbls 24 hours Completed
1934	OWTD
5/9	OTD 3460 1/2 7 Bbls per hr Bee Hunter 3462 TD 3485 47 Bbls per hr.

FIRST REPORTS



COMPLETED

*Harvey*

*43* KANSAS Map No. Sec. *17* Twp. *22* R. *3* <sup>W</sup>

Well No. *1* *Schmidt*

*Dorby Oil Co* Company

Contractor

FIRST REPORTS

.....Ft. from N. Line

*330* Ft. from S. Line

.....Ft. from E. Line

*990* Ft. from W. Line

SECTION PLAT


Location.....

Rig up.....

Drilling and Remarks:

*Blag Rig*

RECORD

Cased.....in.,.....ft.

Sand.....

Gas.....

Oil.....

Total Depth.....

PRODUCTION

1st 24 hrs. Nat.....

1st 24 hrs. after shot.....

Gas.....Cu. Ft.

Dry Hole.....

Abandoned.....

Date

FEB 22 1933

192

CHAS. L. SHERWOOD

Scout

*Harvey*

43 **KANSAS** Sec. 17 Twp. 22 R. 3 <sup>W</sup>

Well No. 1 *Schmier*

*Derby Oil Co*

Company

Contractor

**COMPLETED**

**SECTION PLAT**

..... Ft. from N. Line

330 Ft. from S. Line

..... Ft. from E. Line

990 Ft. from W. Line

o			

Location.....

Rig up.....

Drilling and Remarks:

*Swab 1568 Bls  
24 hours.*

**RECORD**

Cased 6 in., 3434 ft.

Sand 3442 - 3460 1/2

Gas.....

Oil.....

Total Depth 3460 1/2

**PRODUCTION**

1st 24 hrs. Nat.....

1st 24 hrs. after shot.....

Gas..... Cu. Ft.

Dry Hole.....

Abandoned.....

Date

APR 12 1933

192

**CHAS. L. SHERWOOD**

Scout

Map No. 43 Sec. 17 Twp. 22 R. 3W

Well No. 1 - Schmidt

Merby Oil Company  
Contractor

**FIRST REPORTS**

**COMPLETED**

\_\_\_\_\_ Ft. from N. Line

330 Ft. from S. Line

\_\_\_\_\_ Ft. from E. Line

990 Ft. from W. Line

*QWD*

**SECTION PLAT**


Location \_\_\_\_\_

Rig up \_\_\_\_\_

Drilling and Remarks:

*O.T.O. 3460 1/2  
7 bbls per hr*

*Base Hunton 3462*

*47 bbls per hr*

**RECORD**

Cased \_\_\_\_\_ in., \_\_\_\_\_ ft.

Sand \_\_\_\_\_

Gas \_\_\_\_\_

Oil \_\_\_\_\_

Total Depth 3485

**PRODUCTION**

1st 24 hrs. Nat. \_\_\_\_\_

1st 24 hrs. after shot \_\_\_\_\_

Gas \_\_\_\_\_ Cu. Ft.

Dry Hole \_\_\_\_\_

Abandoned \_\_\_\_\_

Date

5-9-34 19

**ORVAL MANNSCHRECK**

Scout