

Harvey

Map No. _____ Sec. 17 Twp. 22 R. 3^w

Well No. 2 Schmidt Farm _____


Herby Oil Co Company _____

330' Ft. from N. Line

_____ Ft. from S. Line

_____ Ft. from E. Line

990' Ft. from W. Line

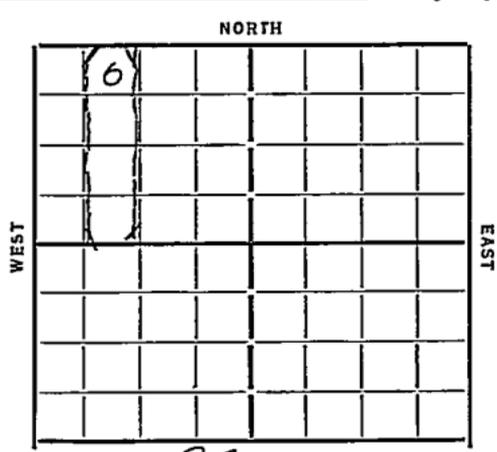

Our lease W²W²S³⁴ - 7-22-3^w

Date	REPORT
7/23	
4/12	R.O. G.
4/19	
4/26	Wrlg 2044'
5/4	" 3048
5/10	Top Chat 3140 Cement 8" 3143 Testing at 3168
5/17	at depth 3252 gauge 74,220,000' gas Base-line 3311 Measured 3401 6" 3403'
5/24	Cem 6" 3403 Bailing
6/1	Re Cementing
6/15	T.D. 3572 Swabbing 40 BARRELS PER HOUR (Telegram)
6/15	1000 gal acid for result in Hunton
	Top Viola 3536-52 Top Dulox 3560
	T.D. 3567 13 1/2 Bbls swabbing
6/21	3570 swabbed 27 bbls per hr
	3572 swabbed 40 " " "
	T.D. 3578' swabbed 1007 bbls 15 hrs
6/28	Top Wilcox 3560 T.D. 3578
	Flow 1275 bbls

COMPLETED

Harvey

W

Map No. **KANSAS** Sec. *17* Twp. *22* R. *3*

Well No. *2* *Schmier*

Derby Oil Co Company

Contractor

FIRST REPORTS


SECTION PLAT

330 Ft. from N. Line

..... Ft. from S. Line

..... Ft. from E. Line

990 Ft. from W. Line

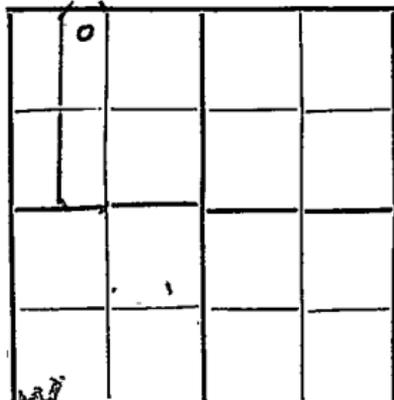

*Our lease
W² W² SE⁴ 7-22-3*

Location.....

Rig up.....

Drilling and Remarks:

ROG

RECORD

Cased.....in.,ft.

Sand.....

Gas.....

Oil.....

Total Depth.....

PRODUCTION

1st 24 hrs. Nat.....

1st 24 hrs. after shot.....

Gas.....Cu. Ft.

Dry Hole.....

Abandoned.....

Date

APR 12 1933

192 CHAS. L. SHERWOOD Scout

Harvey
 Map No. 43 Sec. 17 Twp. 22 R. 3W
 Well No. 2 Schmidt
 Derby Oil Company
 Contractor

SECTION PLAT

330 Ft. from N. Line

..... Ft. from S. Line

..... Ft. from E. Line

990 Ft. from W. Line

COMPLETED

•			

Location.....

Rig up.....

Drilling and Remarks:

Top Wilcox

3560'

Flow 1275 bbls

RECORD.

Cased..... in., ft.

Sand.....

Gas.....

Oil.....

Total Depth. 3578

PRODUCTION

1st 24 hrs. Nat.....

1st 24 hrs. after shot.....

Gas..... Cu. Ft.

Dry Hole.....

Abandoned.....

Date.

6/28/33 192

Oval Mammichew