

Harvey

Map No. _____ Sec. 17 Twp. 22 R. 3^w


Well No. 2 Schmidt Farm
Hollow + Carter Company

330' Ft. from N. Line

_____ Ft. from S. Line

990' Ft. from E. Line

_____ Ft. from W. Line

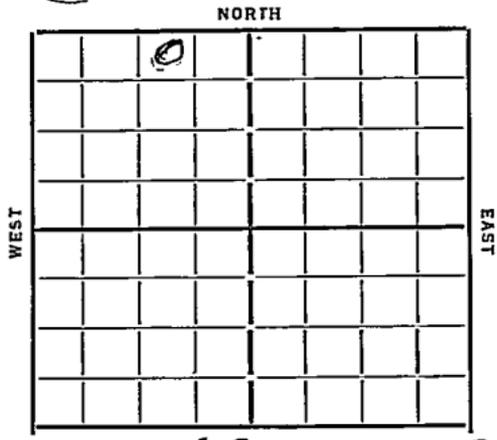

Oil lease W²-W²-S² 6 1/4 7-22-3^w

Date 1933

REPORT

- 4/12 R.O.G.
- 4/19 Reg up Rotary
- 4/26 Cement 12" 282 dely 1780'
- 5/4 dely 2975'
- 5/10 Top Chat 3158 - 8" 3166 dely 3180'
- 5/17 at 3222' gauge 51,278,000 gas base
line 3335 missed 3419 show oil
Top hunter 3421 1/2 run 6" 3422'
- 5/24 Cem 5" 3422' Road
- 6/1 _____
- 6/8 T.D. 3449 - 2600' Oil
- 6/15 dely to 3454 no increase running
 tubing
- 6/21 Top hunter 3421 1/2
T.D. 3454
Est. 1500 bbls per day

COMPLETED

OW DD

1933

- 7/19 Drilling deeper
dly 3542
- 7/26 Top Wilson 3578 pay 3578 - 84 2200'
oil water 3584 - 87 1/2 plugging back

1933

8/2 plugged back to 3585 pump
22 bbl per hr - 15 bbl water
per day

8/9 plugged back 3475' treated 1000 gal
acid

8/17 swab 18 bbl per hr treated 2nd
time - 1000 gal acid

8/23 Well off 3578 T.D. 3587 1/2
1000 gal acid P.D. to 3475
19 bbl per hour

COMPLETED

Harvey

43 KANSAS

Map No. Sec. 17 Twp. 22 R. 3^W

Well No. 2 Schmier

Hollow & Carter Company

Contractor

FIRST REPORTS

SECTION PLAT

330 Ft. from N. Line

Ft. from S. Line

990 Ft. from E. Line

Ft. from W. Line

QW least

N^W SE⁴ 7-22-34

	0		

Location

Rig up

Drilling and Remarks:

ROs

RECORD

Cased in., ft.

Sand

Gas

Oil

Total Depth

PRODUCTION

1st 24 hrs. Nat.

1st 24 hrs. after shot

Gas Cu. Ft.

Dry Hole

Abandoned

Date

APR 12 1933

CHAS. L. SHERWOOD

192

Scout

Map No. 43 *Harvey* Sec. 17 Twp. 22 R. 3W

Well No. 2 *Schmidt*

Hallow & Carter Company

Contractor

SECTION PLAT

330 Ft. from N. Line

..... Ft. from S. Line

990 Ft. from E. Line

..... Ft. from W. Line

COMPLETED

	0		
	.		

Location.....

Rig up.....

Drilling and Remarks:

Top Hunton

3421 1/2

*Est. 1500 bbls
per day*

RECORD

Cased.....in.,ft.

Sand.....

Gas.....

Oil.....

Total Depth. 3454

PRODUCTION

1st 24 hrs. Nat.....

1st 24 hrs. after shot.....

Gas.....Cu. Ft.

Dry Hole.....

Abandoned.....

Date

6/21/33 192 *Oval Mansfield*

Map No. 43 Sec. 17 Twp. 22 R. 3W

Well No. 2-Schmidt

Hallow Company

Contractor

SECTION PLAT

330 Ft. from N. Line

..... Ft. from S. Line

990 Ft. from E. Line

..... Ft. from W. Line

Over All

	o		

FIRST REPORTS
SPECIAL

Location.....

Rig up.....

Drilling and Remarks:

OTN 3454

Qty 3542

RECORD

Cased..... in., ft.

Sand.....

Gas.....

Oil.....

Total Depth.....

PRODUCTION

1st 24 hrs. Nat.....

1st 24 hrs. after shot.....

Gas..... Cu. Ft.

Dry Hole.....

Abandoned.....

Date

7/19/33 192

Oval Manschreck Scout

Map No. 43 Sec. 17 Twp. 22 R. 3W

Well No. 2 - Schmidt

Hallow Company

Contractor

SPECIAL

330 Ft. from N. Line

..... Ft. from S. Line

990 Ft. from E. Line

..... Ft. from W. Line

COMPLETED

SECTION PLAT

10			
1			

Location.....

Rig up.....

Drilling and Remarks:

1000 gal acid

R.B. 3475

19 bbls per hr

RECORD

Cased..... in., ft.

Sand Wiley 3598

Gas.....

Oil.....

Total Depth 3287 1/2

PRODUCTION

1st 24 hrs. Nat.....

1st 24 hrs. after shot.....

Gas..... Cu. Ft.

Dry Hole.....

Abandoned.....

Date

8/23/33 O. Mannschreck Scout