


Harvey

KANSAS

Map No. _____ Sec. 17 Twp. 22 R. 3^W

Well No. #2 Schmidt Farm
Shell Pet Corp Company

340 Ft. from N. Line
____ Ft. from S. Line
____ Ft. from E. Line
330 Ft. from W. Line

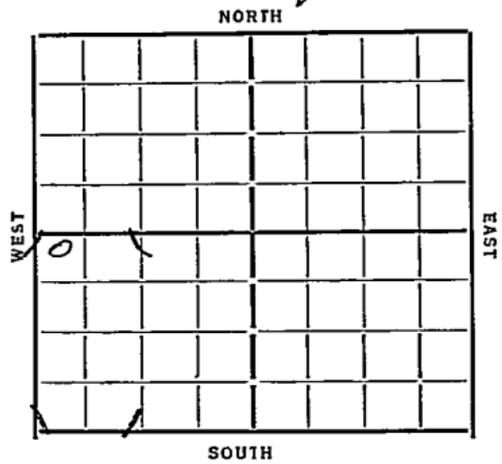

Date	REPORT
1933	
3/22	R. O. G.
3/29	Spud.
4/4	drlg 1120'
4/12	" 2560'
4/19	Top Chat 3163' - Base Lime 3353 drlg 3446
4/26	Henton 3438 - 3443' Cement 7" 3436'
5/4	Pac 3448 - 49 1/2 TD, swab 1902 bbls 24 hrs Not Compd
5/10	No test
5/17	7" casing 3436' Henton 3438 - 49 1/2 TD, Pac 3448' - 49 1/2 Swab 1748 bbls 22 hrs.
	(Completed)

Harvey

43 KANSAS

Map No. _____ Sec. *17* Twp. *22* R. *3*^W

Well No. *3* *Schmidt*

Shell Per Corp Company

Contractor

FIRST REPORTS

340 Ft. from N. Line

_____ Ft. from S. Line

_____ Ft. from E. Line

330 Ft. from W. Line

SECTION PLAT

<i>0</i>			

Location _____

Rig up _____

Drilling and Remarks:

P.O.S.

RECORD

Cased _____ in., _____ ft.

Sand _____

Gas _____

Oil _____

Total Depth _____

PRODUCTION

1st 24 hrs. Nat. _____

1st 24 hrs. after shot _____

Gas _____ Cu. Ft.

Dry Hole _____

Abandoned _____

Date

MAR 22 1933

CHAS. L. SHERWOOD

192

Scout

Harvey

43

KANSAS

Map No. Sec. 17 Twp. 22 R. 3

Well No. 2 Schmier

Sheer put Corp

Company

Contractor

COMPLETED

SECTION PLAT

340 Ft. from N. Line

Ft. from S. Line

Ft. from E. Line

330 Ft. from W. Line

Location

Rig up

Drilling and Remarks:

Pay 3448-49 1/2

Over 17 1/2 hrs
22 hours

RECORD

Cased 7 in., 3434 ft.

Sand *Hunter* 3438-49 1/2

Gas

Oil

Total Depth 3449 1/2

PRODUCTION

1st 24 hrs. Nat.

1st 24 hrs. after shot

Gas

Dry Hole

Abandoned

Date

MAY 17 1933

192

CHAS. L. SHERWOOD

Scout