


Section 17 Township 22 Range 3W

Well No. #2 Schmidt

Company A. D. Allison

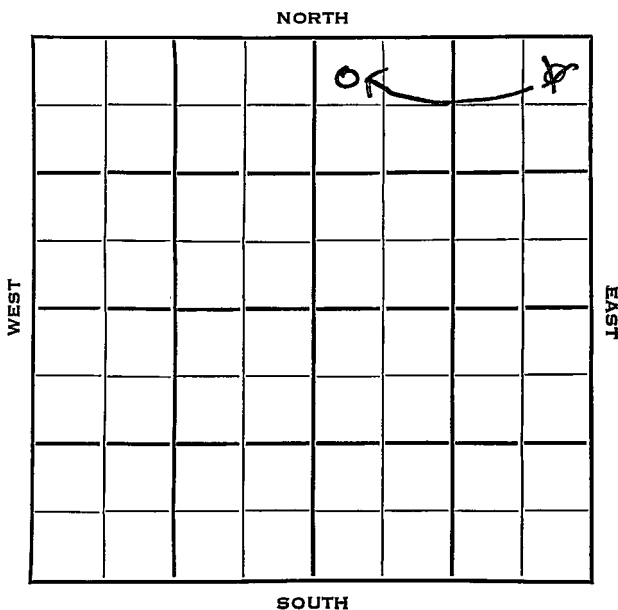

Sec. 17 Twp. 22 R. 3 W

Well No. # 2 Schmidt Farm

A. D. Allison Company

Prime Drlg. Contractor


~~Hollow~~-Nikkle Pool

330 Ft. from N. Line

_____ Ft. from S. Line

~~330~~ Ft. from E. Line

330 Ft. from W. Line

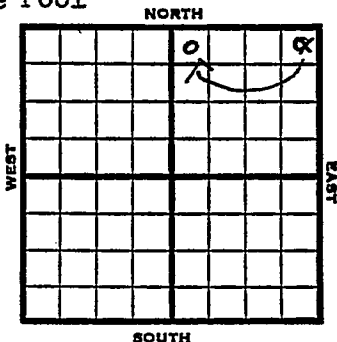

NW NW
~~NE NE NE~~

1953 Elev. 1460' REPORT

3/25 Spud 3-19-53
8" @ 398
Drlg. 2130'

4/2 Drlg 3480

4/9 Htn 3486
TD 3491
5" @ 3490

4/16 NR

4/23 "

4/29 Spud 3-19-53
Oil Well
TD 3517'
8" @ 398'
Hunton 3486,
TD 3491
5" @ 3490'
Miss 3170,
DD 3517 12/3172-76 21/ 3193-3200
Comp. 30 bopd.

COMPI FTFB

County Harvey State Kansas

Sec. 17 (Blk. Twp.) 22 (Sur. Rge.) 3W Map No.

Operator A. D. Allison

Well No. 2 Farm Schmidt

Elev. Location NE NE NE

						0

330 Ft. From N Line NE

330 Ft. From E Line Quarter

1st. Report MAR 25 1953

Completion

Remarks

Prime Drlg. - Contr.

Spudding Date 3-19-53

Drlg. Data Hollow-Nickle Pool

8" @ 398 drlg. 2130

Kansas

Map No. _____ Sec. 17 Twp. 22 R. 3WWell No. 2 Schmidt

_____ A. O. Allison _____ Company

CORRECTION _____ Contractor

NW NW NE

SECTION PLAT

_____ 330 Ft. from N. Line

_____ Ft. from S. Line

_____ Ft. from E. Line

_____ 330 Ft. from W. Line

		o	

Harvey County

Location _____

Rig up _____

Drilling and Remarks:

Reported

NE NE NE

RECORD

Cased _____ in., _____ ft.

Sand _____

Gas _____

Oil _____

Total Depth _____

PRODUCTION

1st 24 hrs. Nat. _____

1st 24 hrs. after shot _____

Gas _____ Cu. Ft.

Dry Hole _____

Abandoned _____

Date

APR 1 1953

J. G. McGEHEE

19

Scout

