


Hawley

Map No. **KANSAS** Sec. *17* Twp. *22* R. *3^w*

Well No. *4 Schmidt* Farm
Shell - Pet Company

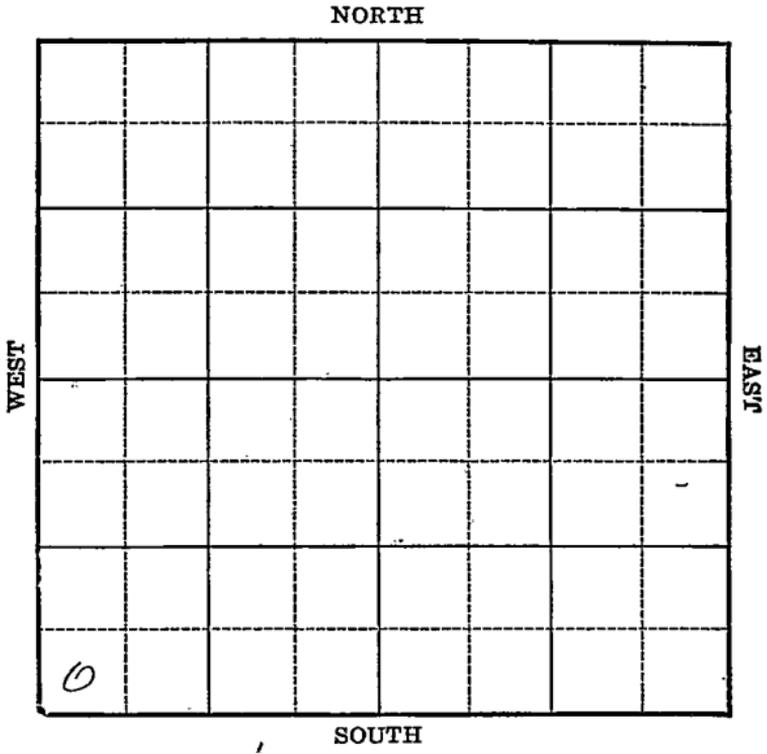

Location _____
Drilling Remarks _____

Rig Up _____
Drilling Remarks _____

RECORD

PRODUCTION

Cased _____ in. _____ ft.

Sand _____

Gas _____

Oil _____

Total Depth _____

1st 24 hrs. Nat. _____

1st 24 hrs. after shot _____

Gas _____ cu. ft.

Dry Hole _____

Abandoned _____

Harvey

Map No. KANSAS Sec. 17 Twp. 22^S R. 3^W

Well No. 4 Schmidt Farm


Shell Pet Company

_____ Ft. from N. Line

330 Ft. from S. Line

_____ Ft. from E. Line

330 Ft. from W. Line

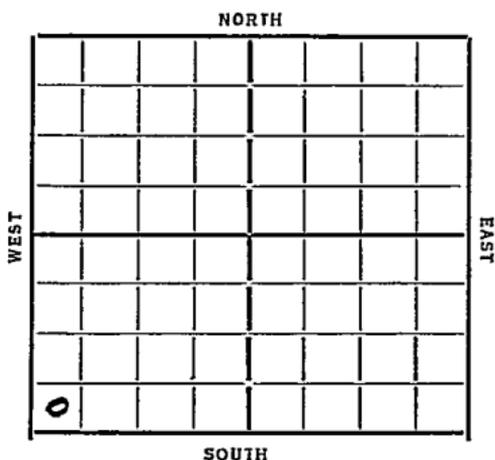

Date
1933

REPORT

10/18 Rotary Rig
10/25 12" 358 - Dreg 890
11/1 Dreg 3020
11/8 Top Chat 3166
Dreg 3321
11/15 Base Line 3357
Hunter 3459
T.D. 3462 set 7' at 3460 woc
11/22 Show gas 3466
at 3475 swab 55 bbls 2 hrs
Dreg deeper
11/28 Hunter 3459-81 T.D. 3484'
1200 bbls

COMPLETED

Map No. 43 Sec. 17 Twp. 22 R. 3W

Well No. 4 - Schmidt

Shellport Company

Contractor

SECTION PLAT

Ft. from N. Line

330 Ft. from S. Line

Ft. from E. Line

330 Ft. from W. Line

FIRST REPORTS

0			

Location.....

Rig up.....

Drilling and Remarks:

Rotary

RECORD

Cased..... in., ft.

Sand.....

Gas.....

Oil.....

Total Depth.....

PRODUCTION

1st 24 hrs. Nat.....

1st 24 hrs. after shot.....

Gas..... Cu. Ft.

Dry Hole.....

Abandoned.....

Date

10-18-33 192 O. Mann Scott

Map No. 43 Sec. 17 Twp. 22 R. 3W

Well No. 4 Schmidt

Shell pet Company

Contractor

COMPLETED

SECTION PLAT

..... Ft. from N. Line

330 Ft. from S. Line

..... Ft. from E. Line

330 Ft. from W. Line

COMPLETED

Location.....

Rig up.....

Drilling and Remarks:

1200 bbls

RECORD

Cased..... in., ft.

Benton Sand 3459-81

Gas.....

Oil.....

Total Depth 3484

PRODUCTION

1st 24 hrs. Nat.....

1st 24 hrs. after shot.....

Gas..... Cu. Ft.

Dry Hole.....

Abandoned.....

Date

11-28-33 O. Mammel Scout