


Harvey

Form 51-5M-11-31-Palace

Map No. **KANSAS** Sec. 17 Twp. 22 R. 3W

Well No. 5 Schmitt Farm
Hollow et al Company

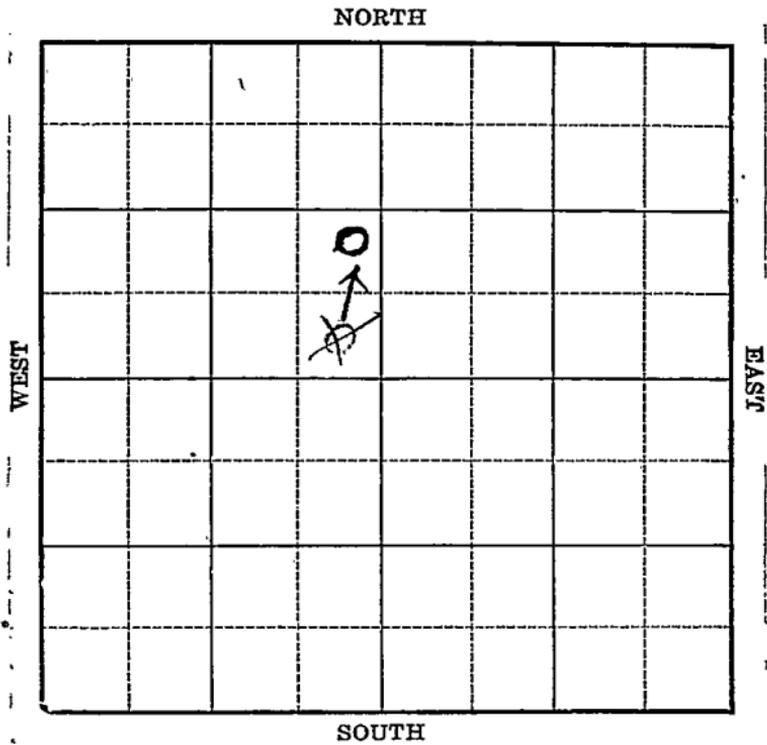

Location _____

Drilling Remarks _____

RECORD

Cased _____ in. _____ ft.

Sand _____

Gas _____

Oil _____

Total Depth _____

Rig Up _____

Drilling Remarks _____

PRODUCTION

1st 24 hrs. Nat. _____

1st 24 hrs. after shot _____

Gas _____ cu. ft.

Dry Hole _____

Abandoned _____

Harvey

Map No. KANSAS Sec. 17 Twp 22 R. 3W


Well No. 5 *Schmitt* Farm
Hallow et al Company

 Ft. from N. Line

330 Ft. from S. Line

330 Ft. from E. Line

 Ft. from W. Line

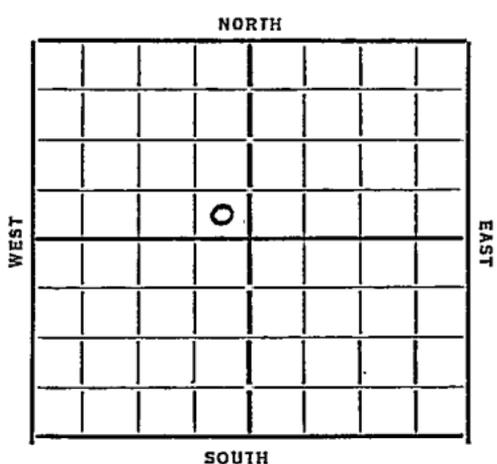

Date
1934

REPORT

<u>3/21</u>	<i>Location</i>
<u>3/29</u>	<i>Rig</i>
<u>4/5</u>	<i>Dly 720</i>
<u>4/12</u>	<i>" 2060</i>
<u>4/19</u>	<i>" 2960</i>
<u>4/26</u>	<i>Chat 3157 B.L. 3360 TD 3451</i>
	<i>Run 7" 3450</i>
<u>5/3</u>	<i>Rust</i>
<u>5/10</u>	<i>Shenton 3449 - 82 TD 3485</i>
	<i>1000 acid swab 6 to 10 Bbls</i>
	<i>per hr.</i>
<u>5/18</u>	<i>20 qt shot swab 3 Bbls</i>
	<i>per hr.</i>
<u>5/25</u>	<i>2000 acid No test</i>
<u>6/6</u>	<i>Shenton 3449 TD 3505</i>
	<i>3500 Gal acid</i>
	<i>360 Bbls oil</i>

COMPLETED

Map No. 43 Sec. 17 Twp. 22 R. 3W

Well No. 5 - Schmidt

Hallow et al Company

Contractor

FIRST REPORTS

SECTION PLAT

..... Ft. from N. Line

330 Ft. from S. Line

330 Ft. from E. Line

..... Ft. from W. Line

	0		

Location

Rig up.....

Drilling and Remarks:

RECORD

Cased..... in., ft.

Sand.....

Gas.....

Oil.....

Total Depth.....

PRODUCTION

1st 24 hrs. Nat. 20750

1st 24 hrs. after shot.....

Gas..... Cu: Ft.

Dry Hole.....

Abandoned.....

Date

3/21/37 192 O. Munnick Scout

Harvey
 Map No. 43 Sec. 17 Twp. 22 R. 3W

Well No. 5-Schmidt
Hollow et al. Company

Contractor

COMPLETED

SECTION PLAT

		3	

_____ Ft. from N. Line

330 Ft. from S. Line

330 Ft. from E. Line

_____ Ft. from W. Line

NESE 7W

Location _____

Rig up _____

Drilling and Remarks:

3500 gal oil

360 bbls
oil

RECORD

Cased _____ in., _____ ft.

Sand Hutton 3449

Gas _____

Oil _____

Total Depth 3505

PRODUCTION

1st 24 hrs. Nat. _____

1st 24 hrs. after shot _____

Gas _____ Cu. Ft.

Dry Hole _____

Abandoned _____

Date

6-6-34 19 A. Manschreck Scout