



Map No. KANSAS Sec. 17 Twp. 22 R. 3w

Well No. 1-Schultz Schmidt Farm

Hollow-Carter et al company


\_\_\_\_\_ Ft. from N. Line

330 Ft. from S. Line

990 Ft. from E. Line

\_\_\_\_\_ Ft. from W. Line

1932

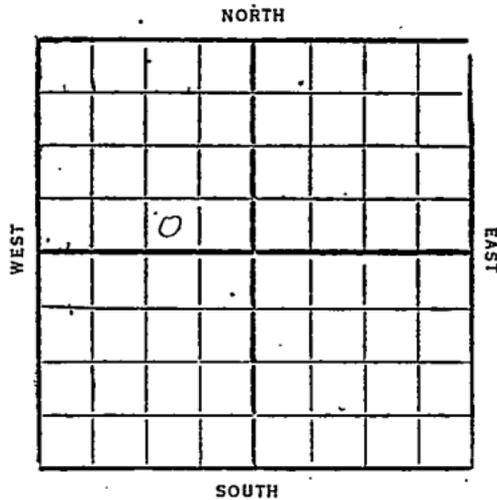

Date	REPORT
11/2	Bldg rig
11/9	dig
11/16	Rig up
11/23	154286
	dreg 826'
11/30	" 2181'
12/7	" 2815'
12/14	Top chat 3149 (Cem 8"-3149
	TD 3157 Rust
12/21	TD 3160' Bailing
12/28	TD 3160
	8" csg collapsed suddging
1933	
1/4	TD 3160' (Rust)
1/11	
1/18	TD 3160
	Run 8" 2350'
1/25	TD 3160' dreg cem 2200
2/11	Dreg 2785' (new hole.)
2/18	" 3120'

2/15 - Top Chat 3148

8" - 3157

Est 1/2 M gas 3160

" 1 1/2 M " 3166

Gauge 6,850,000 ft gas 3172

" 14,358,000 " " 3189-93

" 16,900,000 " " 3194-97

2/22 - 23 M gas 3208

show oil 3217

Increase 3219

Est 25 M gas and 50 bbl  
oil per day 3221

3221 = 3217

Deepened to

TD 3257

Gauge 8,115,000 ft gas

No increase oil

Run 6" csg

3/4 T.D. 3332 in line cleaning out

3/7 - B.S. 3352' measured sand 3436-38'

Top Hunton 3438' 5" lined 3442 - 250' oil

3442' - 500' oil 3446' - 1000' oil 3452

Pay 3454 - 55 - 2400' oil 14 1/2 hrs 3455'

TD 3461' no increase

3/15 - T.D. 3464 - S.L. M. flow 1690 bbls  
in 20 hrs 43 gravity at 70

3/22 - Hunton 3438-64

Pay 3454-55

T. D. 3464

flow 1690 bbls 20 hours

Gas lift

(Completed)

OWD

1934

5/2 O.T.D. 3473 Deepened 3493

Increased production from 15 to 60  
bbls per hr.

FIRST REPORTS

COMPLETED

*Harney*

43 KANSAS Sec. 17 Twp. 22 R. 3<sup>W</sup>

Well No. 1 *Schultz*


*Hollow-Carter et al* Company

Contractor

### FIRST REPORTS

.....Ft. from N. Line  
330 Ft. from S. Line  
990 Ft. from E. Line  
.....Ft. from W. Line

### SECTION PLAT

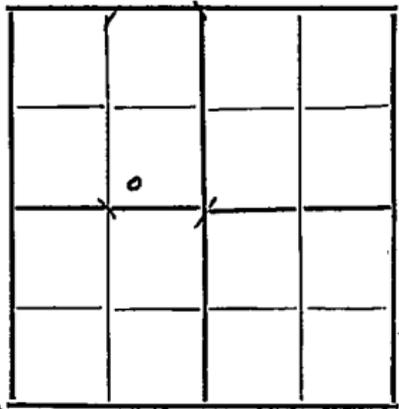

Location.....  
Rig up.....  
Drilling and Remarks:  
*Blow Rig*

### RECORD

Cased.....in., .....ft.  
Sand.....  
Gas.....  
Oil.....  
Total Depth.....

### PRODUCTION

1st 24 hrs. Nat.....  
1st 24 hrs. after shot.....  
Gas.....Cu. Ft.  
Dry Hole.....  
Abandoned.....

Date

NOV 2 1932 CHAS. L. SHERWOOD

192 Scout

Harvey

W

KANSAS


Sec. 17 Twp. 22 R. 3

g. 1 Schmiat  
Hollow-Carter & Co. Company

Contractor

CORRECTION

SECTION PLAT

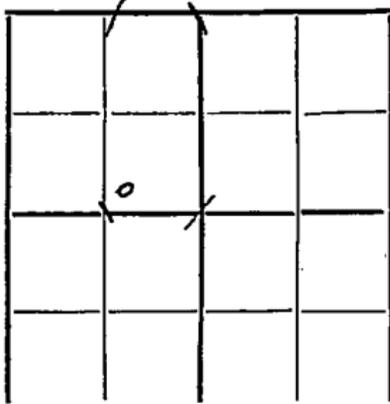

Ft. from N. Line

330 Ft. from S. Line

990 Ft. from E. Line

Ft. from W. Line

Location.....

Rig up.....

Drilling and Remarks:

Chy Farm  
Same to  
Abous

RECORD

Cased..... in., ..... ft.

Sand.....

Gas.....

Oil.....

Total Depth.....

PRODUCTION

1st 24 hrs. Nat.....

1st 24 hrs. after shot.....

Gas..... Cu. Ft.

Dry Hole.....

Abandoned.....

Date

MAR 2 2 1933

*Harney*

~~Map No.~~ **KANSAS**

Map No. \_\_\_\_\_ Sec. *17* Twp. *22* R. *3*<sup>w</sup>

Well No. *1 Schmier*

*Hollow-Carter Co* Company

Contractor

**COMPLETED**


**SECTION PLAT**

\_\_\_\_\_ Ft. from N. Line

*330* Ft. from S. Line

*990* Ft. from E. Line

\_\_\_\_\_ Ft. from W. Line

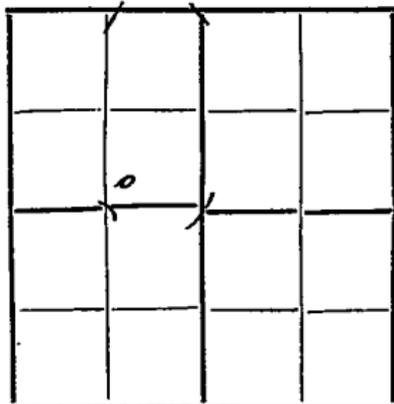

Location \_\_\_\_\_

*Hunter*

Rig up \_\_\_\_\_

Drilling and Remarks:

*Pay 3454-55'*

*Flow 1690 Bbls  
20 Hours,  
Gas light.*

**RECORD**

Cased \_\_\_\_\_ in., \_\_\_\_\_ ft.

Sand *3438-3464*

Gas \_\_\_\_\_

Oil \_\_\_\_\_

Total Depth *3464*

**PRODUCTION**

1st 24 hrs. Nat. \_\_\_\_\_

1st 24 hrs. after shot \_\_\_\_\_

Gas \_\_\_\_\_ Cu. Ft.

Dry Hole \_\_\_\_\_

Abandoned \_\_\_\_\_

Date

**MAR 22 1933**

**CHAS. L. CHERWOOD**

192

Scout

Map No. 43 Sec. 17 Twp. 22 R. 3W

Well No. 1 - Schmidt

≡ Hallow etal Company

Contractor

**FIRST REPORTS**



**COMPLETED**

\_\_\_\_\_ Ft. from N. Line

330 Ft. from S. Line

990 Ft. from E. Line

\_\_\_\_\_ Ft. from W. Line

**SECTION PLAT**

	0		

QWDD

Location \_\_\_\_\_

Rig up \_\_\_\_\_

Drilling and Remarks:

O.T.D. 3473

Deepened 3493

Increased production from 15 to 60 bbls per hour

**RECORD**

Cased \_\_\_\_\_ in., \_\_\_\_\_ ft.

Sand \_\_\_\_\_

Gas \_\_\_\_\_

Oil \_\_\_\_\_

Total Depth \_\_\_\_\_

**PRODUCTION**

1st 24 hrs. Nat. \_\_\_\_\_

1st 24 hrs. after shot \_\_\_\_\_

Gas \_\_\_\_\_ Cu. Ft.

≡ Dry Hole \_\_\_\_\_

Abandoned \_\_\_\_\_

Date \_\_\_\_\_

5-2-34 19

**ORVAL MANNSCHRECK**

Scout