


Section 17 Township 22 Range 31W

Well No. 1 Neumann

Company Northern Pump & CRA

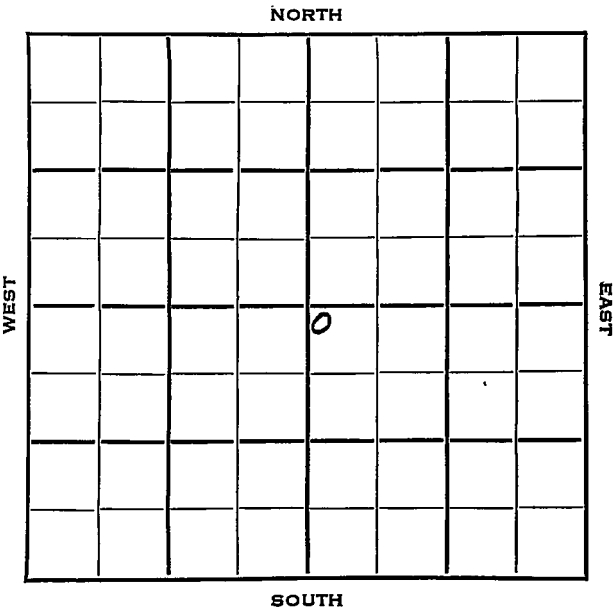

Finney

KANSAS

SEC.	TWP.	R.
17	22	31 W ✓

WELL NO.

1 Neumann

FARM

COMPANY

Northern Pump & CRA

CONTRACTOR

Northern Pump

~~Perm~~ Hugoton Pool


100 Ft. from N. Line

Ft. from S. Line

Ft. from E. Line

100 Ft. from W. Line

NW NW SE

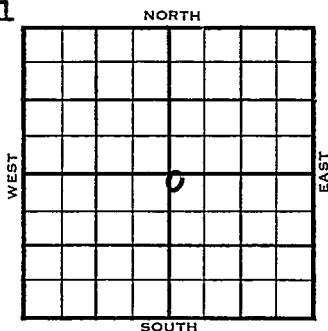

1953

ELEVATION

2918'

REPORT

Permian test

11/11

Spud 11-6-53

10" @ 344'

Drlg. 2350'

11/18

Her. 2684', Kr. 2704', Win 2760',
RTD 2765'

Log.

5" @ 2765'

CO 2765'

12/9

NR

~~11/20~~

1954

1/20

NR

3/3

NR

3/10

Spud 11-6-53

Gas Well

TD 2765'

10" @ 344'

Her 2684', Kri 2704', Win 2760'

TD 2765'

5" @ 2763'

CO 2765, 40/2684-94, 96/2706-30

dolo-frac

Comp. 3,125,000 gas

COMPLETED

J. G. McGEHEE