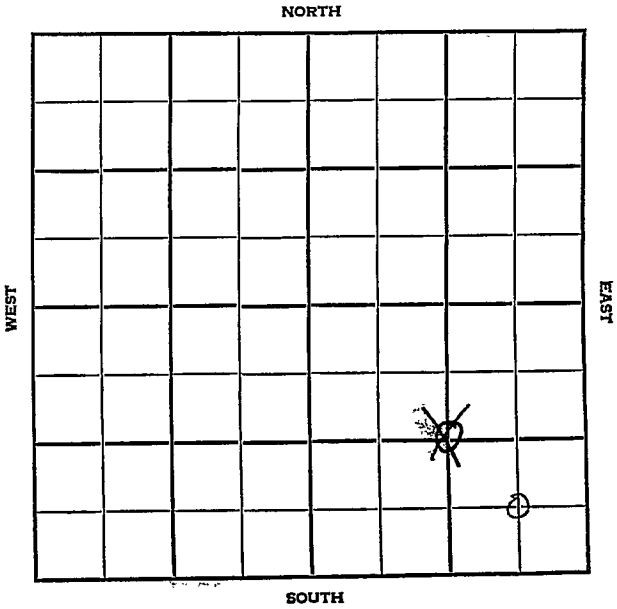


Section 17 Township 22 Range 33WWell No. 1 Finnup "B"Company W. L. Hartman

Finney

Kansas

SEC.	TWP.	R.
17	22	33W 1

WELL NO.

1 Fynnup "B"

FARM

COMPANY

W. L. Hartman

CONTRACTOR

H & H Drlg.

Damme Pool

_____ Ft. from N. Line


~~660~~
~~1320~~

_____ Ft. from S. Line

~~660~~
~~1320~~

_____ Ft. from E. Line

_____ Ft. from W. Line

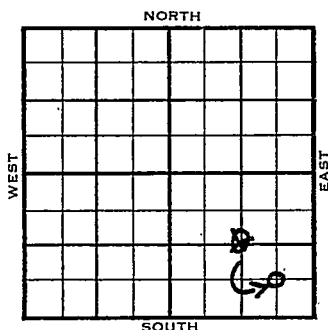

CSESE

~~CSE/4~~

1954

ELEVATION

2899

REPORT

6/30

Spudding 6-24-54

10" @ 295

Drlg. 2245

7/7

 RTD 2702' 5" @ 2702 Hol 2513
 Her. 2546' Kr. 2562' Win 2594'
 Gage 2619' Up Ft. 2657'

7/21

WOCT

8-11

Spdg 6-24-54

Gas well

TD 2702

10" @ 295

Hol. 2513 Her. 2546 Kri. 2562

Win. 2594

TD 2702

5" @ 2702

Ft. Riley 2657 CO to 2625 88/ 2596--

2618 500 A frac 200, 000 cfg 40/ --

2565-75 40/ 2549-59 5000 A frac

Comp. 3,000,000 cfcpd

COMPLETED

County **Finney** State **Kansas**Sec. **17** (Blk.) **22** (Sur. Rge.) **33W** Map No.Operator **W. L. Hartman**Well No. **1** Farm **Finney "B"**Elev. Location **C SE/4****1320** Ft. From **S** Line **SE****1320** Ft. From **E** Line Quarter1st. Report **JUN 30 1954**

Completion

Remarks

H & H Drlg. - Contr.Spudding Date **6-24-54**Drlg. Data **Demme Pool****10" @ 295 drlg. 2245****J. G. McGEHEE**

Map No. _____ Sec. 17 Twp. 22 R. 33WWell No. 1 Finnup "B"W. L. Hartman Company**CORRECTION**

Contractor

C SE SE

SECTION PLAT

			6

_____ Ft. from N. Line

660 Ft. from S. Line660 Ft. from E. Line

_____ Ft. from W. Line

Finney County

Location _____

Rig up _____

Drilling and Remarks:

Reported

C SE/4

RECORD

Cased _____ in., _____ ft.

Sand _____

Gas _____

Oil _____

Total Depth _____

PRODUCTION

1st 24 hrs. Nat. _____

1st 24 hrs. after shot _____

Gas _____ Cu. Ft.

Dry Hole _____

Abandoned _____


Date

JUL 7 1954

19

J. G. McGEHEE Scout

County Finney State Kansas
 Sec. 17 (Blk.) 22 (Sur.) 33W Map No.
 Operator W. L. Hartman
 Well No. 1 Farm Finnup "B"
 Elev. 2899 Location C SE SE

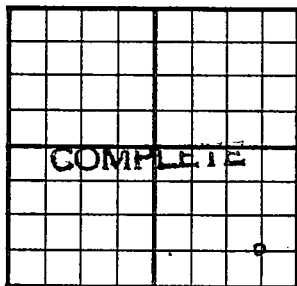

660 Ft. From S Line SE
660 Ft. From E Line Quarter
 1st. Report
 Completion AUG 11 1954
 Remarks Damme Pool
H & H Drlg. - Contr.
 Spudding Date 6-24-54

Drlg. Data Gas well TD 2702
10" @ 295 Hol 2513 Her. 2546
Kri. 2562 Win. 2594 TD 2702 5" @ 2702
Ft. Riley 2657 CO to 2625 88/ 2596-2618
500 A frac 200,000 cfg 40/ 2565-75
40/ 2549-59 5000 A frac
Comp. 3,000,000 cfgpd