


Section 17 Township 22 Range 33 W

Well No. # 1 Garden

Company Kansas-Nebraska

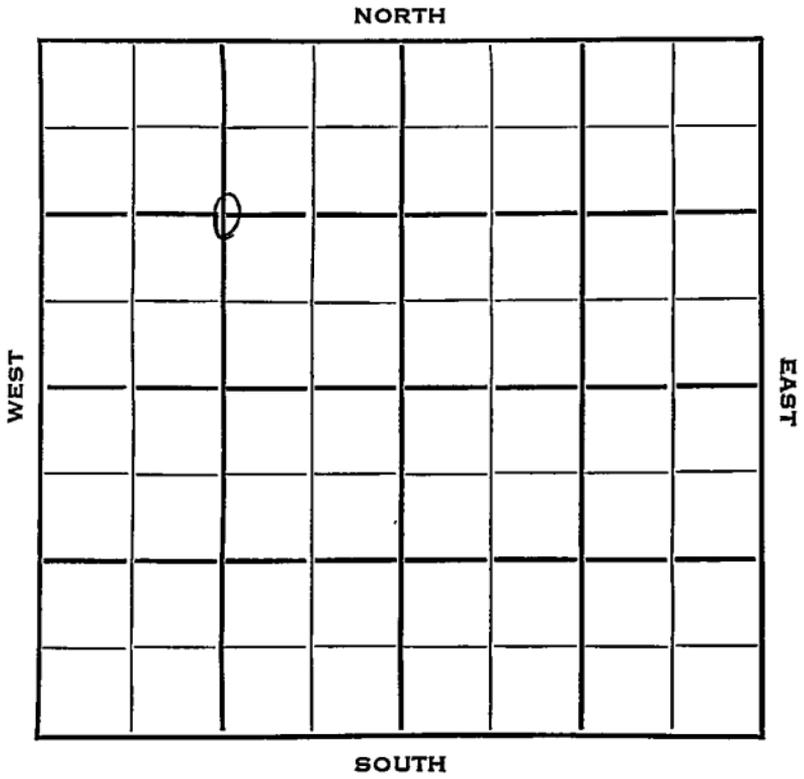

Finney

KANSAS

SEC.	TWP.	R.
17	22	33 W ✓

WELL NO. # 1 Garden FARM

COMPANY Kansas-Nebraska

CONTRACTOR Nonaker Drlg.

Hugoton Pool


1320 Ft. from N. Line

Ft. from S. Line

Ft. from E. Line

1320 Ft. from W. Line


G NW/4

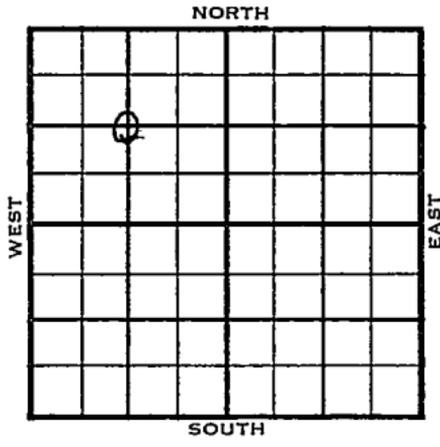

	ELEVATION	REPORT
1954	2895'	
4/7	Spud 3-31-54 Her. 2535' Kri. 2547' Win. 2581' TD 2585' 8" @ 300 5" @ 2584	
5/5	WOGF	
5/12	"	
5/26	"	
6/2	"	
6/23	Spud 3-31-54 Gas well TD 2608 Her. 2535 Kri. 2547 Win. 2581 TD 2585 8" @ 300 5" @ 2584 DD 2608 1000 A VSSG 48/2536-44 78/2547-60 2000 A dol-frac. 2,178,000 gas. frac. Comp. 1,647,000 CFGPD	

COMPLETED

County Finney State Kansas
 Sec. 17 (Blk. 22) (Sur. 33W) (Twp.) (Rge.) Map No.
 Operator Kansas-Nebraska
 Well No. 1 Farm Garden
 Elev. 2895 Location C NW/4

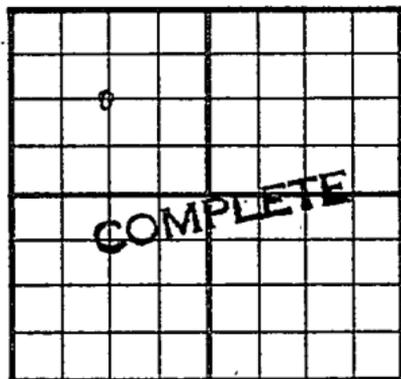

1320 Ft. From N Line NW
1320 Ft. From W Line Quarter
 Ist. Report
 Completion JUN 23 1954
 Remarks Hugoton Pool
Honaker Drlg. - Contr.
 Spudding Date 3-31-54

Drlg. Data Gas well TD 2608
Her. 2535 Kri. 2547 Win. 2581
TD 2585 8" @ 300 5" @ 2584 DD 2608
1000 A VSSG 48/ 2536-44 78/ 2547-60
2000 A dol-frac 2,178,000 gas frac
Comp. 1,647,000 cf gpd

J. G. MCGEHEE