


Section 18 Township 22 Range 11W


Well No. #1 Evans

Company Hinkle & Franco Central
Wildcat

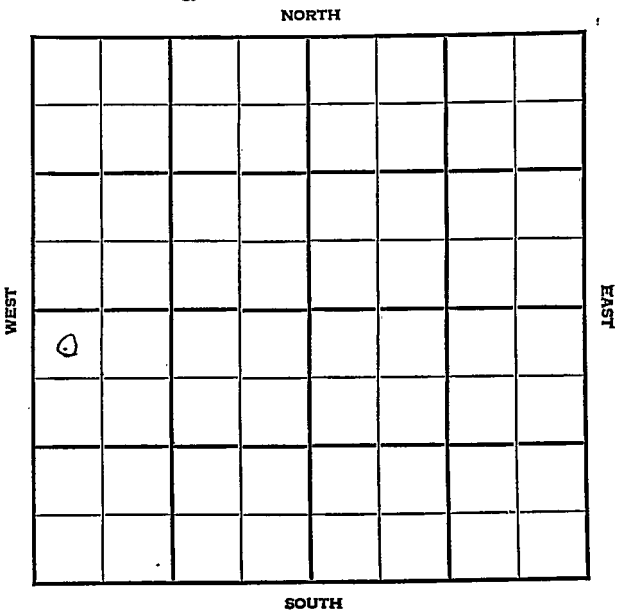

Sec. 18 Twp. 22 R. 11WWell No. #1 Evans FarmHinkle & Franco Central Company
Wildcat330 Ft. from N. Line Ft. from S. Line Ft. from E. Line330 Ft. from W. Line

NW SW

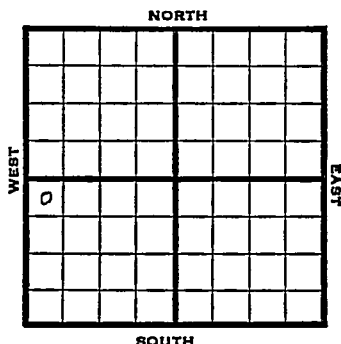

1948

Elev. 1885' REPORT

4/14

RUR

4/21

8" @ 200'

Drlg. 2615'

4/28

Lansing 3273'

Viola 3549'

Simpson 3579'

Arbuckle 3643'

TD 3648½'

5/5

Arbuckle 3643'

TD 3667'

ABANDONED

Map No. _____ Sec. 18 Twp. 22 R. 11W

Well No. 1 Evans

Einkle & Franco Central Company

FIRST REPORT

Contractor

NW SW


SECTION PLAT

330 Ft. from N. Line

_____ Ft. from S. Line

_____ Ft. from E. Line

330 Ft. from W. Line

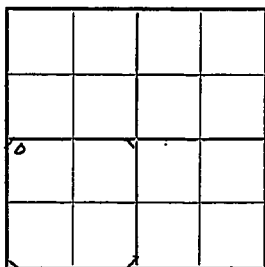

Stafford County

Location _____

Rig up _____

Drilling and Remarks:

R U R

RECORD

Cased _____ in., _____ ft.

Sand _____

Gas _____

Oil _____

Total Depth _____

PRODUCTION

1st 24 hrs. Nat. _____

1st 24 hrs. after shot _____

Gas _____ Cu. Ft.

Dry Hole _____

Abandoned _____

Date

APR 14 1948 19

S. J. LEWIS Scout

Map No. 46 Sec. 18 Twp. 22 R. 11W

Well No. 1 Evans

Hinkle & Franco Central Company
ABANDONED

Contractor

NW SW

E. 1. 1983
SECTION PLAT

0			

330 Ft. from N. Line

 Ft. from S. Line

 Ft. from E. Line

330 Ft. from W. Line

Stafford County

Location

Rig up

Drilling and Remarks:

OK 36 K?

RECORD

Cased in.; ft.

Sand

Gas

Oil

Total Depth 9669

PRODUCTION

1st 24 hrs. Nat.

1st 24 hrs. after shot

Gas Cu. Ft.

Dry Hole

Abandoned

Date

MAY 5 1948 19 S. J. LEWIS Scout