

**KANSAS**

**Stafford**

Section 18 Township 22 Range 12-W

Well No. #1 Teichman

Company Finston & Murfin

**NORTH**

WEST

**EAST**

**SOUTH**

Sec. 18 Twp. 22 R. 12-W

Well No. #1 Teichman Farm

Finston & Murfin Company

Drach Contractor


           Ft. from N. Line

330 Ft. from S. Line

330 Ft. from E. Line

           Ft. from W. Line

SE SE SW

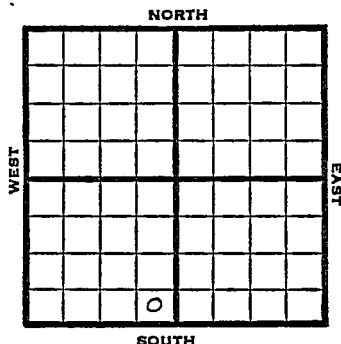

1950

Elev 1878

REPORT

8/2 8" @ 231  
Anhy 695  
Drlg 1965

8/16 8" @ 231  
Anhy 695  
Br lime 3351  
Cong 3635  
Simp 3690  
DST 3647-83 opn  $\frac{1}{2}$  hr rec 25' ocm  
DST 3753-68 opn 1 hr rec 950' wtr  
TD 3768  
D&A

Heeb 3206

Lans 3373

Viola 3646

Arb 3752

**ABANDONED**

Kansas

Drach Pool

Map No. \_\_\_\_\_ Sec. 18 Twp. 22 R. 12W

Well No. 1 Teichman


Finston &amp; Murfin

Company

Contractor

SE SE SW

## SECTION PLAT

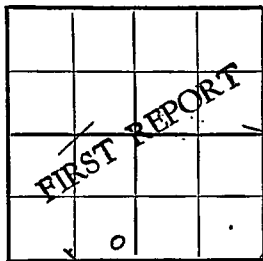

\_\_\_\_\_ Ft. from N. Line

330 Ft. from S. Line

330 Ft. from E. Line

\_\_\_\_\_ Ft. from W. Line

Stafford County

Location \_\_\_\_\_

Rig up \_\_\_\_\_

Drilling and Remarks:

8" @ 231

Anhy 695

drlg. 1965

## RECORD

Cased \_\_\_\_\_ in., \_\_\_\_\_ ft.

Sand \_\_\_\_\_

Gas \_\_\_\_\_

Oil \_\_\_\_\_

Total Depth \_\_\_\_\_

## PRODUCTION

1st 24 hrs. Nat. \_\_\_\_\_

1st 24 hrs. after shot \_\_\_\_\_

Gas \_\_\_\_\_ Cu. Ft.

Dry Hole \_\_\_\_\_

Abandoned \_\_\_\_\_


Date

J. E. TYRA

AUG 2 1950 19

Scout

County Stafford State Kansas  
 Sec. 18 (Blk. 22 (Sur. 12W Map No.  
 (Twp.) (Rge.)  
 Operator Finston & Murfin  
 Well No. 1 Farm Teichman  
 Elev. 1878 Location SE SE SW

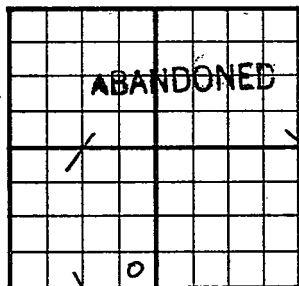

330 Ft. From S Line SW  
330 Ft. From E Line Quarter  
 Ist. Report  
 Completion AUG 16 1950  
 Remarks  
Drach Pool  
 Spudding Date

Drlg. Data D & A TD 3768  
8" @ 231 Anhy 695 Heeb. 3206  
Br. line 3351 Lans. 3373 Cong. 3635  
Viola 3646 Simp. 3690 Arb. 3752  
DST 3647-83 open  $\frac{1}{2}$  hr. Rec. 25' ocm  
DST 3753-68 open 1 hr. Rec. 950' water  
TD 3768 D & A

J. E. TYRA