

Harvey

KANSAS


Form 51-5M-11-31-Palace

Map No. _____ Sec. 18 Twp. 22 R. 3W

Well No. 4 Neufeldt B Farm

Sinclair - Prairie Company

NORTH

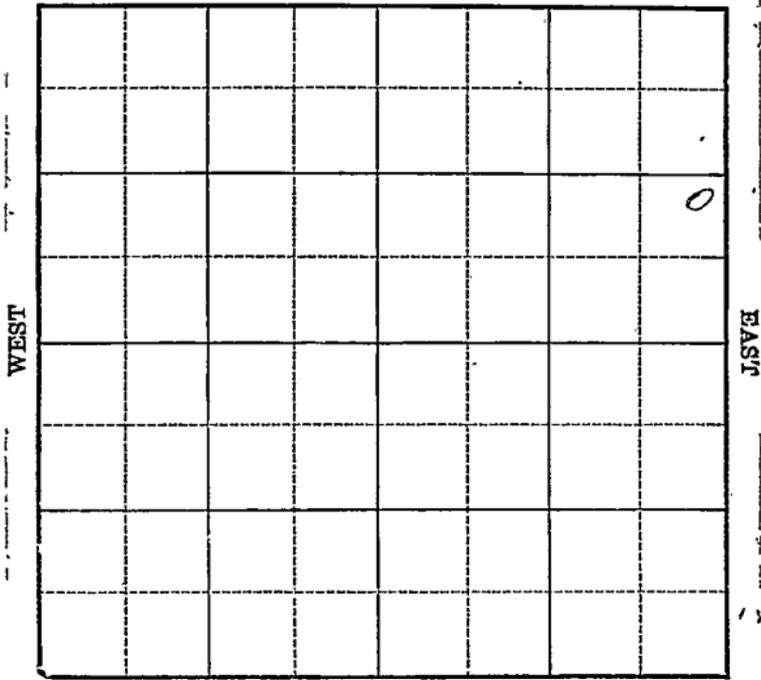

SOUTH

Location _____

Drilling Remarks _____

Rig Up _____

Drilling Remarks _____

RECORD

Cased _____ in. _____ ft.

Sand _____

Gas _____

Oil _____

Total Depth _____

PRODUCTION

1st 24 hrs. Nat. _____

1st 24 hrs. after shot _____

Gas _____ cu. ft.

Dry Hole _____

Abandoned _____

Map No. _____ Sec. 18 Twp. 22 R. 3W

Well No. 4-Neufeldt B1 Farm _____


Sinclair - Prairie Company _____

_____ Ft. from N. Line

990 Ft. from S. Line

330 Ft. from E. Line

_____ Ft. from W. Line

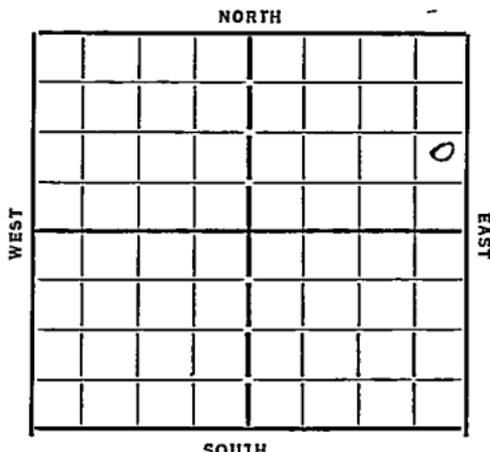

Date	REPORT
7/26	Cellar
8/2	Regn up
8/9	12" 334 drlg 1510'
8/17	drlg 3020'
8/23	Top Chat 3136 - 8" 3145 T.D. 3148' R.U.S.J.
8/30	8" Collapsed
9/6	Lost bailers 4/13 - fog
9/20	Regn up Rotary
9/29	fishing
10/15	fishing
10/11	Re-cement pipe
10/18	T D 2770 fishing
10/25	drlg 3079
11/1	Base Miss 3304
.	Top Hunton 3406 - run 7"
11/8	— 11/15 —
11/22	Base Hunton 3440 T.D. 3444
11/28	2000' oil - swab 12 bbls per bar Hunton 3406 - 40 T.D. 3444 1000 gal acid 2400 lb

COMPLETED

Harvey Co
Map No. 430 Sec. 18 Twp 22 R. 3W

Well No. 4 - Newfield B1

Sinclair Prairie Company

Contractor

SPECIAL

..... Ft. from N. Line

990 Ft. from S. Line

330 Ft. from E. Line

..... Ft. from W. Line

FIRST REPORTS

SECTION PLAT

			o

Location.....

Rig up.....

Drilling and Remarks:

clean

RECORD

Cased..... in., ft.

Sand.....

Gas.....

Oil.....

Total Depth.....

PRODUCTION

1st 24 hrs. Nat.....

1st 24 hrs. after shot.....

Gas..... Cu. Ft.

Dry Hole.....

Abandoned.....

Date

7/26/33 192 O. Manschreck Scout

Map No. 43 Sec. 18 Twp. 22 R. 3W

Well No. H-Neufeldt 1B1

Sinclair Prairie Company

Contractor

COMPLETED

SECTION PLAT

..... Ft. from N. Line

990 Ft. from S. Line

330 Ft. from E. Line

..... Ft. from W. Line

			0

Location.....

Rig up.....

Drilling and Remarks: ..

1000 gal acid

240 bbls

RECORD

Cased in., ft.

Sand Huntow 3406-40

Gas.....

Oil.....

Total Depth 3444

PRODUCTION

1st 24 hrs. Nat.....

1st 24 hrs. after shot.....

Gas..... Cu. Ft.

Dry Hole.....

Abandoned.....

Date

11-28-33 O. M. Muesel Scout