


Section 18 Township 22 Range 1W

Well No. #1 Ediger

Company Glickman & Finston

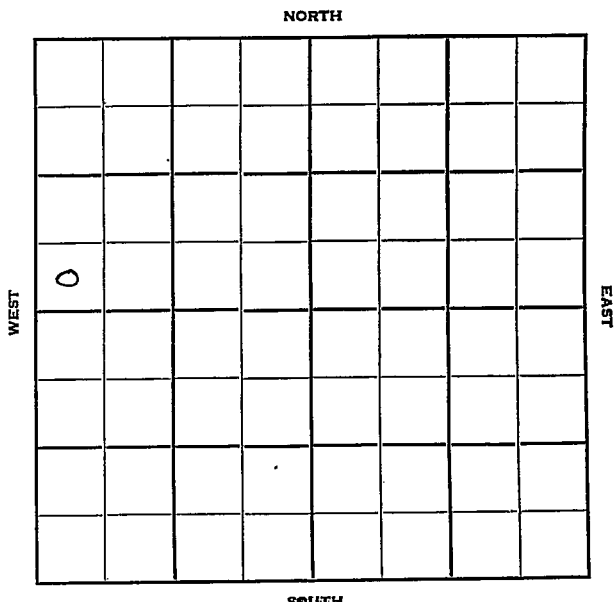

Reno

KANSAS

Sec. 18 Twp. 22 R. 1W

Well No. #1 Ediger Farm

Glickman & Finston Company

Mallard Contractor
Wildcat

 Ft. from N. Line


330 Ft. from S. Line

 Ft. from E. Line

330 Ft. from W. Line

SW SW NW

Skelly DHM

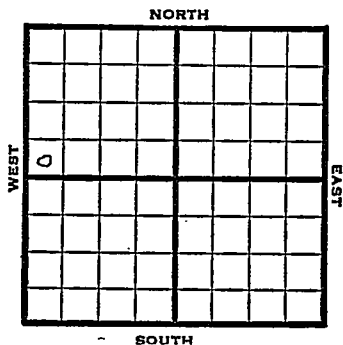

1952 Elev. 1168' REPORT

3/5 Location

3/12 "

3/19 "

3/25 8" @ 180' Drlg. 1587'

4/1 Miss 3340'

Drlg. 3556'

4/9 Spud 3-22-52

D & A TD 3965' 8" @ 180'

Miss 3340' Simp. 3858'

DST 3854-66 open 1 hr. rec 6' mud

Arb. 3945-65' TD

D & A

ABANDONED

County **Reno** State **Kansas**

Sec. **18** (Blk. **22** (Sur. **4W** Map No.

Operator **Glickman & Finston**

Well No. **1** Farm **Ediger**

Elev.	Location	SW	SW	NE
-------	----------	----	----	----

0

FIRST REPORT

330 Ft. From S Line NW

330, Ft. From  Line Quarter1st. Report **MAR 5 1952**

Completion

Remarks **Shelly - DEM**

Mallard - Contr.

Spudding Date

Drlg. Data **Wildcat**

Location b6
b7C

J. G. McGEHEE

County Reno State Kansas
 Sec. 18 (Blk. Twp.) 22 (Sur. Rge.) 4W Map No. _____
 Operator Glickman & Finston
 Well No. 1 Farm Ediger
 Elev. 1468 Location SW SW NW

0							

330 Ft. From S Line NW
 330 Ft. From W Line Quarter
 1st. Report _____
 Completion APR 9 1952
 Remarks Wildcat
Mallard - Contr.
 Spudding Date 3-22-52

Drilg. Data D & A TD 3965
8" @ 180 Miss. 3340 Simp. 3858
DST 3854-66 open 1 hr. Rec. 6' mud
Arb. 3945-65 TD

D & A

J. G. McGEHEE