


Section 18 Township 22 Range 17 WWell No. #1 EikmeierCompany Jones, Shelburne & Farmer

NORTH

WEST

EAST

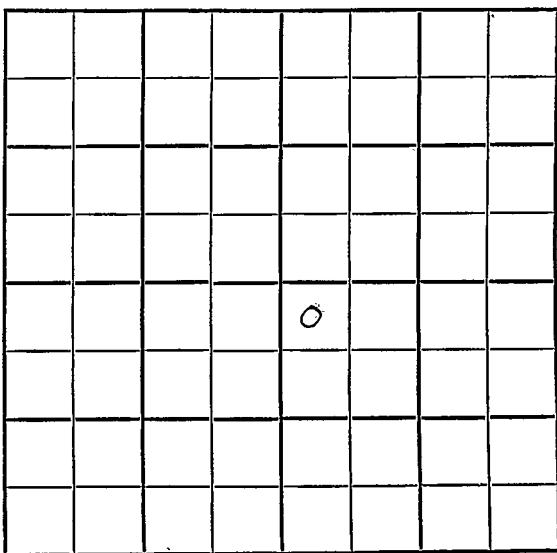

SOUTH

Pawnee County, Kansas

SEC.	TWP.	R.
18	22S	17W

WELL NO.

#1 Eikmeier

FARM

COMPANY

Jones, Shelburne & Farmer, Inc.

CONTRACTOR

Co. Tools

NORTH

Wild-cat Ft. from N. Line

Ft. from S. Line

Ft. from E. Line

Ft. from W. Line

WEST

EAST

SOUTH

Dry hole money \$2500.00

Arbuckle Test NW NW SE Mag-Support

1955

ELEVATION 2067 KB
2064 4300 Foot Test REPORT (WH5-DC82)

10/5

To Start October 1, 1955
To Complete November 15, 1955

9/22

Spud 9-14-55
8 5/8" casing set 278' with 200 Sks
Dlg. 2470

10-6

Heeb. 3599, Doug. 3620,
Br.Lime 3685, Lans. 3696
BKC 3977, Cong. 4137
Viola 4212, Simpl 4274
Arb. 4326,
TD 4376,
DST 4138-85, op 1/2 hr. rec 15' socm,
110/20"
5 1/2" @ 4376,
WOCT

10-13

Waiting on cable tools

10-20

CO to 4265, 32/ 4158-62, 500 A, rec. 10
gw w/ scum oil, 1 hr. sq. w/ 68 sks.WOC

10-27

CO to 4158, 48/ 4133-41, 54/ 4144-53,
B/ 5 gwph, 500 A, to frac.

OVER

1955
11/2

Comm. 9-14-55
8-5/8" @ 278/200
DST 4138-85, open $\frac{1}{2}$ hr rec 15' SOCM
110/20" 5 $\frac{1}{2}$ " @ 4376 CO to 4265
32/4158-62 500 A. Rec 10 GW
scum oil 1 hr. CO to 4158 48/4133-41
54/4144-53 B/5 GWPH 500 A.
D & A. TD 4376'
Tops: H. 3599', Dg 3620', BL 3685',
L. 3696', BKC 3977', C. 4137'
V. 4212' S. 4274', A. 4326'
TD 4376' D & A

ABANDONED

#

11-9

Advised Contract Section

County Pawnee Elev. _____
 Sec. 18 Twp. 22 Rge. 17W
 Company Jones, Shelburne & Farmer
 Farm Name Eikmeier No. 1

TOPS	DEPTH	LOG	DATUM	Loc. in Sec.
Anh.				NW NW SE
Tp.				
H.				
Tr.				
Dg.				
Bl.				
L.				
K.C.				Geol.
B.K.C.				Contr.
Ce.				Co. tools
C.				Pool
M.				Wildcat
M.				
K.				
Mz.				
Mo.				
V.				
S.				
S.				
A.				
R.				
P.C.				
G.				
T.D.				

SDX - DNM
 FIRST REPORT
 10
 SEP 1

Date Comm. Magnolia FO & Support
drill.

2064 DF

2067 KB

County Pawnee

Elev.

Sec. 18

Twp.

22

Rge.

17W

Company

Jones, Shelburne & Farmer

FarmName

EikmeierNo. 1

TOPS

DEPTH

LOG

DATUM

Loc. in Sec.

Anb.

Tp.

H.

Tr.

Dg.

Bl.

L.

K.C.

B.K.C.

Ce.

C.

M.

M.

K.

Mz.

Me.

V.

S.

S.

A.

R.

Pe.

G.

T.D.

NW NW SE


Geol.

Contr.

Co. tools

Pool

Wildcat

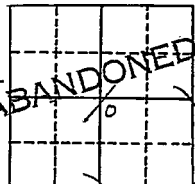Date Comm. 9-14-55

NOV 2 1955

8 5/8" @ 278/200 DST 4138-85 open 1/2 hrrec. 15' socm 110/20" 5 1/2" @ 4376CO to 4265 32/ 4158-62 500 A rec. 10 grscum oil 1 hr. CO to 4158 1/8/ 4133-4151/ 4114-53 B/ 5 gwph 500 A

D & A