


Finney

KANSAS

SECTION 18 TOWNSHIP 22S RANGE 32W

WELL NO. #1 Amy Grub

COMPANY Southwestern Exploration

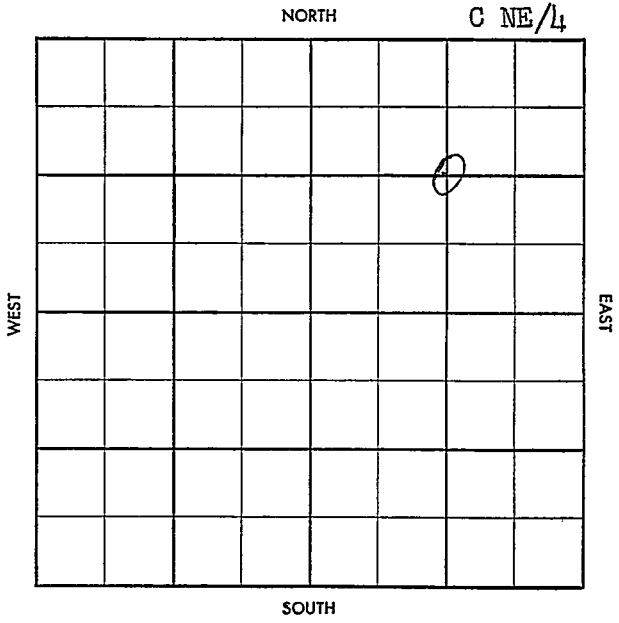



Twp ~~Pool~~  
 Co. ~~Facet~~

S-513-A

CO. Finney ELEV. 2873  
 SEC. 18 TWP. 22 RGE. 32W  
 COMPANY Southwestern NO. 1  
Exploration

APR 23 '58  
**COMPLETE**

FARM Amy Grub

LOC. C NE/4  
Continental PO

<u>WIN 2652</u>
<u>Kn 2568</u>
<u>Ukn 2594</u>
<u>Lkn 2616</u>
<u>RTD 2710</u>
<del>RTD 2710</del>

GEOL. \_\_\_\_\_  
 CONTR. Garvey  
 POOL Hyaton  
 SPUD 9-27-57  
 8" 400/  
 OUT 9 37 5" 2690/450  
 OCT 17 57  
 NOV 57 WOLT

JAN 15 58  
 FEB 12 58 FEB 10 58

HAR E TO W O DEN  
 CD 2686 ran log  
 48/2652-64 ga 500 met  
 p.d. mat SIP 51 12 hrs SIP  
 408 ga 4.500 - 120"  
 Tstg 3 57 64/2596-2612 52/2616-2912  
 72-20 ga. 14.000 met  
 SIP 400 hce. 10 x 10 1/2 d

CO.  
 LSE.  
 NO.  
 SEC.  
 TWP.  
 RGE.