

Section 19 Township 22 Range 11WWell No. #1 CochlinCompany Anderson-Prichard

NORTH

0							


WEST

EAST

SOUTH

Sec. 19 Twp. 22 R. 11 W ✓Well No. # 1 Cochlin FarmAnderson-Prichard CompanyB & B Drlg. ContractorWildcat Ft. from N. Line330 Ft. from S. Line Ft. from E. Line330 Ft. from W. Line

SW SW SW

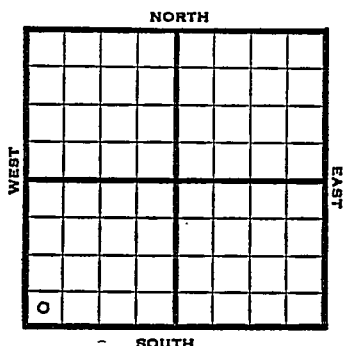

1951 Elev. 1850' REPORT

9/12 Spud 8-29-51
8" @ 249 Anhy 590' Heeb 3122'
Br. lime 3259' Lans. 3286'
DST 3430-50 open $\frac{1}{2}$ hr. gas in 4 min.
rec 40' OCM, 120' HOCM, 70' VHOCM
50' SW
B KC 3511' Cong. 3554' Viola 3558'
Simp. 3601'
DST 3624-35 open 1 hr. rec 20' OCM
show of free oil.
Arb. 3658' TD 3660' 5" @ 3659'

10/3 Spud 8-29-51
Oil well TD 3660' 8" @ 249'
Anhy 590' Heeb 3122' Br. lime 3259'
Lans. 3286'
DST 3430-50 open $\frac{1}{2}$ hr. gas in 4 min.
rec 40' OCM, 120' HOCM, 70' VHOCM
50' SW.
B KC 3511' Cong. 3554' Viola 3558'
Simp. 3601'
DST 3624-35 open 1 hr. rec 20' OCM
show of free oil.
Arb. 3658' TD 3660' 5" @ 3659'
CO to 3660' S/35 BO 7 hr.
S/6 BOPH 4 hr.
Comp. 210 BOPD

COMPLETED

County **Stafford** State **Kansas**

Sec. **19** (Blk. **22** (Sur. **11W** Map No.

Operator Anderson-Prichard

Well No. **1** Farm **Gochlin**

Elev.	Location	SW	SW	SW
-------	----------	----	----	----

0 ✓

330 Ft. From S Line SW

330 Ft. From IV Line Quarter

1st. Report SEP 12 1951

Completion _____

Remarks

B & B Drlg. - Contr.

Spudding Date 8-29-51

Drig. Data **Wildcat**

8" @ 249 Anhy 590 Heeb. 3122

Br. lime 3259 Lang. 3286 DST 3430-50

open $\frac{1}{2}$ hr. gas in 4 min. Rec. 40⁺ cc

120⁺ hoem 70⁺ vhoem 50⁺ sw B HC 3511


Cong. 3554 Viola 3558 Simp. 3601

DST 3624-35 open 1 hr. Rec. 20* ocm

show of free oil Arb. 3658 TD 3660

5" @ 3659

J. E. TYRA

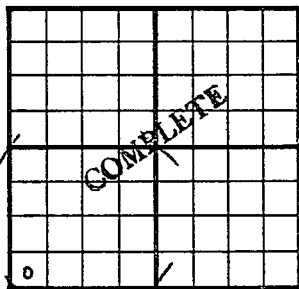County Stafford State KansasSec. 19 (Blk. Twp.) 22 (Sur. Rge.) 11W Map No.Operator Anderson-PrichardWell No. 1 Farm CochlinElev. 1850 Location SW SW SW330 Ft. From S Line SW330 Ft. From W Line Quarter1st. ReportCompletion OCT 3 1951Remarks WildcatB & B Drlg. - Contr.Spudding Date 8-29-51Drlg. Data Oil well TD 36608" @ 249 Anhy 590 Heeb. 3122Br. lime 3259 Lans. 3286 DST 3430-50open $\frac{1}{2}$ hr. gas in 4 min. Rec. 40' ocm120' hocm 70' vhocm 50' sw B KC 3511Cong. 3554 Viola 3558 Simp. 3601DST 3624-35 open 1 hr. Rec. 20' ocmshow of free oil Arb. 3658 TD 36605" @ 3659 CO to 3660 S/ 35 bo 7 hr.S/ 6 boph 4 hr. Comp. 210 bopd

J. E. TYRA