


Stafford KANSAS

SECTION 19 TOWNSHIP 22 RANGE 12 W

WELL NO. #1 Krankenberg

COMPANY Transit & Monsanto

NORTH

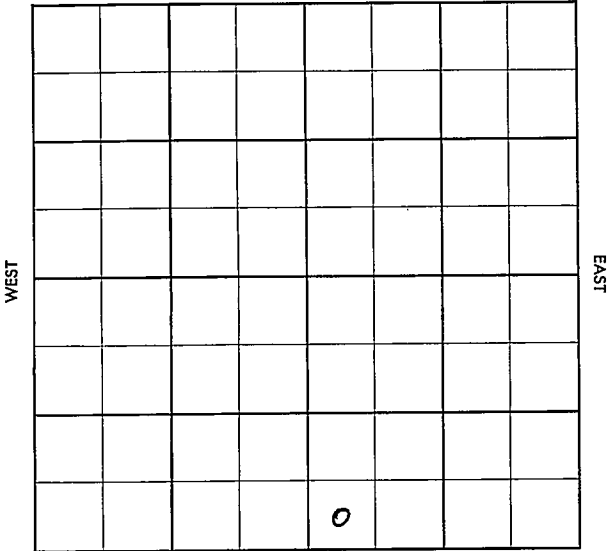

SOUTH

Stafford

KANSAS

SEC.	TWP.	R.
19	22	12W

WELL NO.

#1 Krankenberg

FARM

COMPANY

Transit & Monsanto

CONTRACTOR

Transit

WILDCAT


_____ Ft. from N. Line

_____ Ft. from S. Line

_____ Ft. from E. Line

_____ Ft. from W. Line

SW SW SE

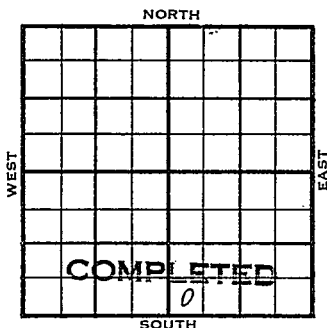

1956	ELEVATION	REPORT
------	-----------	--------

1-5 Loc.

County Stafford Elev. _____Sec. 19 Twp. 22 Rge. 12WCompany Transit & MonsantoFarm Name Krankenber No. 1

TOPS	DEPTH	LOG	DATUM
Anh.			
Tr.			
H.			
Tr.			
Dg.			
BL.			
L.			
K.C.			
B.K.C.			
Ce.			
C.			
M.			
M.			
K.			
Mz.			
Ms.			
V.			
S.			
S.			
A.			
R.			
PE.			
G.			
T.D.			

Loc. in Sec. _____

SW SWSE

Geol. _____

Contr. _____

Transit

Pool _____

Wildcat

JAN 5 56		
FIRST REPORT		

Date Comm. _____

Location

23

County **Stafford** Elev. **1874**
 Sec. **19** Twp. **22** Rge. **12W**
 Company **Transit & Monsanto**
 Farm Name **Krankenber** No. **1**

TOPS	DEPTH	LOG	DATUM	Loc. in Sec.
Ank				SW SWSE
TP				
H.	3197			
Tr.				
Dp	3232			
Bl.	3330			
L.	3348		1474	Geol.
K.C.			1699	Contr.
BKC	3573			Transit
Co.				
C.				Pool
M.				Wildcat
N.				
Ne				
No	3630		1756	
V.	3695		1821	
S.				
S.	3757		1883	
A.				
R.				
PC.				
G.				
SA	3761			

MAR 7 1956

Date Comm.

Location JAN 11 '56 1-6-56 85/8 229

1100 @ 2885 JAN 18 '56 DST 3476-

3530 @ 40" rec 30' Md (550)

BHP 205 DST 3629-79 @ 40"
rec 30' Md BHP 650/20

DST 3695-3726 1hr rec 1800'

GIP Rec 270' HOS GCM FP 70 14)

BHP 1280/20" (500 3727-34)

5 1/2 @ 3760 JAN 25 '56 ~~5 1/2 @ 3760~~ CO

DD 3767 & 5 BWph 50d
 OH 3761-67 WOC FEB 1 '58
 12/3731-35 100 acid Frac
 & 2 1/2 BFph 50% wth
 Plg @ 3725 30/3711-16
 FU 100' Fluid 1hr N/A FU
 1400' Fluid 12 hrs & 5 BF
 30% wth 1hr & 2 B0 7% w
 1hr Frac FEB 8 '58 & 70 B0 in
 8 hrs & rate 6 Bophr
 n.o/w FEB 15 '58 P.O.P. FEB 22 '58 P. 38
 B0 in 7 hrs P 44 B0 in
 12 hrs FEB 29 '58 P. 74 1/2 B0 +
 5 1/2 BWpd. MAR 7 '58 Ph P 126
 Bopd + 8% wth grow 38°

MAR 19 1956
 9561