

Harvey

KANSAS


Form 51-5M-11-31-Palace

Map No. _____ Sec. 19 Twp. 22 R. 3W

Well No. 3 Edger Farm

Sinclair-Prairie Company

NORTH

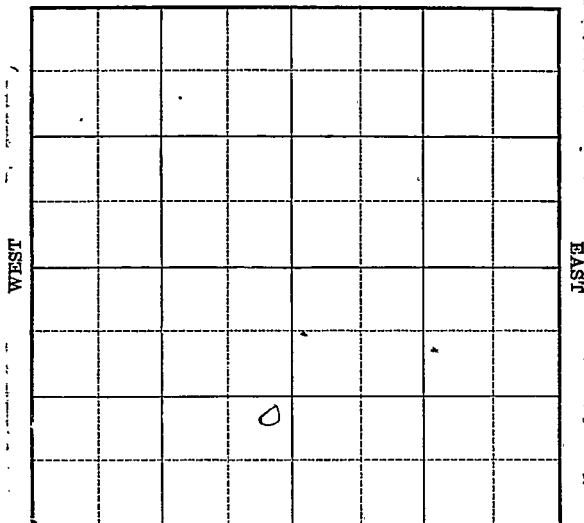

SOUTH

OWDD

Location _____

Drilling Remarks _____

Rig Up _____

Drilling Remarks _____

RECORD

Cased _____ in. _____ ft.

Sand _____

Gas _____

Oil _____

Total Depth _____

PRODUCTION

1st 24 hrs. Nat. _____

1st 24 hrs. after shot _____

Gas _____ cu. ft.

Dry Hole _____

Abandoned _____

Map No. _____ Sec. 19 Twp. 22 R. 3W


Well No. 3 Ediger Farm
Sinclair-Prairie Company

_____ Ft. from N. Line

990 Ft. from S. Line

330 Ft. from E. Line

_____ Ft. from W. Line

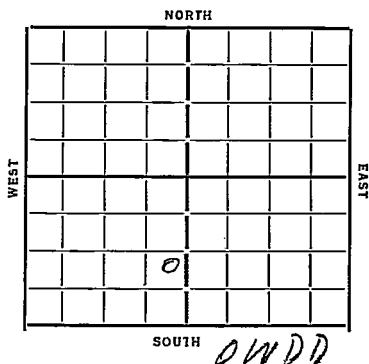

Date 1933 REPORT

7/26 Location
8/2 Bldg Rq
8/9 12" 304 WOO
8/17 dly 2180
8/23 Top Chat 3125 8" 3135 T.D. 313P RU 87
8/30 _____
9/6 B.L. 3288 - T.D. 3327 - Run 6"
9/13 Top Hunton 3327 - Pay 3350-54
flow 765 bbls 10 hrs
9/20 _____
9/27 Hunton 3327-57
swab + flow
730 bbls 16 hours
T.D. 3365

1934 COMPLETED

7/18 Rgn to deepen
7/26 Bly 3460
8/2 Viola 3466 - 89 TWX 3491
600' oil 3535 Swab 30 Bbls 20 hrs.
8/9 Shot 30 gts 3502 - 32
Swab 89 Bbls 6 hrs.

8/16 Shot 30 gts 3502-32
Swab 89 Bbls 6 hrs,

8/22 Hilcox 3491 TD 3532
30 gts 607 Bbls,

COMPLETED


Map No. 43 Sec. 19 Twp. 22 R. 3W

Well No. 3-Edison

Sinclair-Prairie Company

Contractor

SECTION PLAT

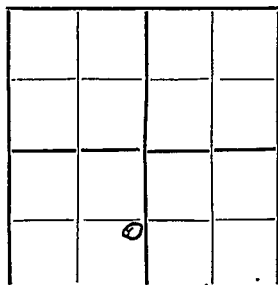

Ft. from N. Line

990 Ft. from S. Line

330 Ft. from E. Line

Ft. from W. Line

~~PIPSA RECORDS~~

Location

Rig up

Drilling and Remarks:

RECORD

Cased in., ft.

Sand

Gas

Oil

Total Depth

PRODUCTION

1st 24 hrs. Nat.

1st 24 hrs. after shot

Gas Cu. Ft.

Dry Hole

Abandoned

Date

7/26/33 192 O. Manschreck Scout

Map No. 43 Sec. 19 Twp. 22 R. 3W

Well No. 3-Edgewood

Sinclair-prairie Company

Contractor

SECTION PLAT

Ft. from N. Line

990 Ft. from S. Line

330 Ft. from E. Line

Ft. from W. Line

COMPLETED

Location

Rig up

Drilling and Remarks:

swab + flow
730 bbls
16 hrs

RECORD

Cased _____ in., _____ ft.

Sand Hutton 3327-57

Gas _____

Oil _____

Total Depth 3365

PRODUCTION

1st 24 hrs. Nat. _____

1st 24 hrs. after shot _____

Gas _____ Cu. Ft.

Dry Hole _____

Abandoned _____

Date SEP 27 1923

O. Mammel Scout

Map No. 43 Sec. 19 Twp. 22 R. 3W

Well No. 3-Edgewood


FIRST DEPOSITS Contractor

SECTION PLAT

 Ft. from N. Line

990 Ft. from S. Line

330 Ft. from E. Line

 Ft. from W. Line

OWD

Location

Rig up

Drilling and Remarks:

OTV 3365

RECORD

Cased in., ft.

Sand

Gas

Oil

Total Depth

PRODUCTION

1st 24 hrs. Nat.

1st 24 hrs. after shot

Gas Cu. Ft.

Dry Hole

Abandoned

Date

7-18-34 19

ORVAL MANNSCHRECK

Scout

KANSAS

Map No. 43 Sec. 19 Twp. 22 R. 3W

Well No. 3-Ediger

Sinclair-Prairie Company
Contractor

COMPLETED

SECTION PLAT

	0		

_____ Ft. from N. Line

990 Ft. from S. Line

330 Ft. from E. Line

_____ Ft. from W. Line

Location _____

Rig up _____

Drilling and Remarks:

30 ft

607 bbls

RECORD

Cased _____ in., _____ ft.

Sand Wilcox 3491

Gas _____

Oil _____

Total Depth 3532

PRODUCTION

1st 24 hrs. Nat. _____

1st 24 hrs. after shot _____

Gas _____ Cu. Ft.

Dry Hole _____

Abandoned _____

Date

8-22-31

19

ORVAL MANUSCRIPTS Scout