


Map No. KANSAS Sec. 19 Twp. 22 R. 3WWell No. 6 Edger Farm
Sinclair - Prairie Company

NORTH

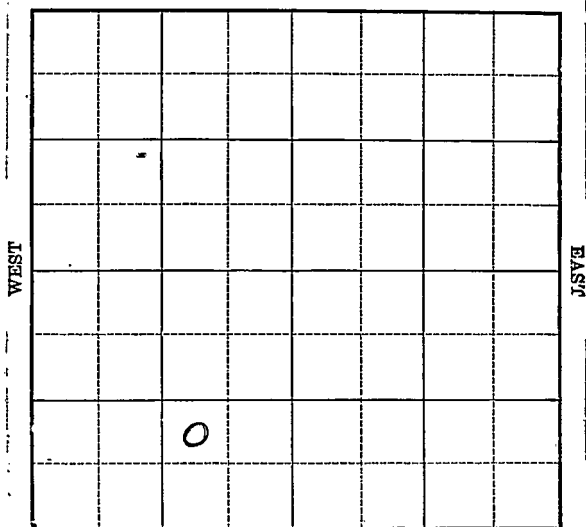

SOUTH

Location _____

Drilling Remarks _____

Rig Up _____

Drilling Remarks _____

RECORD

Cased _____ in. _____ ft.

Sand _____

Gas _____

Oil _____

Total Depth _____

PRODUCTION

1st 24 hrs. Nat. _____

1st 24 hrs. after shot _____

Gas _____ cu. ft.

Dry Hole _____

Abandoned _____

Harvey

Map No. KANSAS Sec. 19 Twp 22 R. 3W

Well No. 6 Edger Farm


Sinclair - Prairie Company

 Ft. from N. Line

990 Ft. from S. Line

990 Ft. from E. Line

 Ft. from W. Line

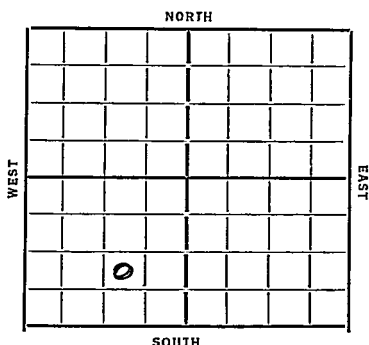

Date 1934

REPORT

3/21 Location
3/29 — 4/5 — 4/12 —
4/19 Dlg 1968
4/26 " 2917
5/3 Chrt 3154 B.L. 3230
TD 3335 8" 4 3333 Rust
5/10 Hunton 3364 TD 3367
400' oil
5/18 1000 Gal acid swab 10 Bbls
per hr.
5/25 Dlg 3511 5" 3487
5/31 Fighting Crow 3612
6/7 Viola V 3630 TD 3666
Wilcox 3663 PB 3648
6/14 7 sq liner
6/21 PB 3504 164' 678 liner
shot 20 qts swelling liner
6/28 Co
7/5 — 7/12 — 7/19 — 7/26 —
8/2 —
— OVER —

8/8 Henton 3335

Visla 3630

Wilcox 3663

TJ 3666

PA 3504 60 Bbl oil

COMPLETED

KANSAS

Map No. 43 Sec. 19 Twp. 22 R. 3WWell No. 6-EdgerSnclair prairie Company

Contractor

FIRST REPORTS**SECTION PLAT**

	0		

Ft. from N. Line

990 Ft. from S. Line990 Ft. from E. Line

Ft. from W. Line

Location ☒

Rig up

Drilling and Remarks:

RECORD

Cased.....in.,ft.

Sand.....

Gas.....

Oil.....

Total Depth.....

PRODUCTION

1st 24 hrs. Nat:.....

1st 24 hrs. after shot:.....

Gas.....Cu. Ft.

Dry Hole.....

Abandoned.....

Date

3/21/34 192 O. W. Manschreck Scout

KANSAS

Map No. 43 Sec. 19 Twp. 22 R. 3W

Well No. 6-Ediger

Sinclair-Prairie Company

COMPLETED

Contractor

SECTION PLAT

	0		

_____ Ft. from N. Line

990 Ft. from S. Line

990 Ft. from E. Line

_____ Ft. from W. Line

Location _____

Rig up _____

Drilling and Remarks:

Hinton 3335
Viola 3630
Wilcox 3663.

P.B. 3504
60 bbl oil

RECORD

Cased _____ in., _____ ft.

Sand _____

Gas _____

Oil _____

Total Depth 3666

PRODUCTION

1st 24 hrs. Nat. _____

1st 24 hrs. after shot _____

Gas _____ Cu. Ft.

Dry Hole _____

Abandoned _____

Date

8-8-34 19

ORVAL MANNSCHRECK

Scout