



Map No. KANSAS Sec. 19 Twp. 22 R. 3<sup>w</sup>

Well No. 2-Martens Farm


Wrost-Studley & Curry Company

1221 Ft. from N. Line

\_\_\_\_\_ Ft. from S. Line

330 Ft. from E. Line

\_\_\_\_\_ Ft. from W. Line

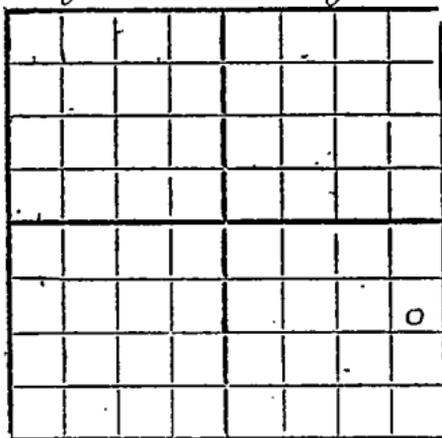

1932

Date	REPORT
11/2	D/S
11/19	—
11/16	—
11/23	Hdg Reg
11/30	Regn Rotary
12/7	Dreg 15"-453'
	Dreg 575'
12/14	" 2224'
12/21	" 2896'
12/28	Top Chat <del>3190</del> 3216
	Cem 8"-3200' (rust)
1933	—
1/4	—
1/11	—
1/18	Dreg 3215'
1/25	Top Chat 3216' (SWM)
	Cem 8"-3226
	Show oil & water 3252
	Cem case 3282' 51
2/1	Dreg 3325
	(over)

2/8- Base lime 3348  
6"-3378  
SD 3381

2/15 —  
2/22- 6"-3380

TD 3404 drlg cement

3/4 will re cement

3/8 Top Hunton 3441' running 5"  
liner

3/10 Top Hunton 3448-5" liner 3448  
show oil 3448-58' increase oil  
3458-62' show 3462-64' increase  
3472-75 J.D. 3480 swab 500 bbls  
6 hrs.

3/22- Hunton 3448-3480  
swab 500 bbls  
in 6 hours  
(Completed)

Harvey

43 KANSAS

Map No. \_\_\_\_\_ Sec. 19 Twp. 22 R. 3

Well No. 2 Martens

Frost-Stuey & Curry Company

Contractor

FIRST REPORTS

1221 Ft. from N. Line

\_\_\_\_\_ Ft. from S. Line

330 Ft. from E. Line

\_\_\_\_\_ Ft. from W. Line

SECTION PLAT

			○

Location \_\_\_\_\_

Rig up R.O.G.

Drilling and Remarks:

RECORD

Cased \_\_\_\_\_ in., \_\_\_\_\_ ft.

Sand \_\_\_\_\_

Gas \_\_\_\_\_

Oil \_\_\_\_\_

Total Depth \_\_\_\_\_

PRODUCTION

1st 24 hrs. Nat. \_\_\_\_\_

1st 24 hrs. after shot \_\_\_\_\_

Gas \_\_\_\_\_ Cu. Ft.

Dry Hole \_\_\_\_\_

Abandoned \_\_\_\_\_

Date

NOV 2

1932

CHAS. L. SHERWOOD

192

Scout

Harvey

W1

43 KANSAS

Map No. \_\_\_\_\_ Sec. 19 Twp. 22 R. 3

Well No. 2 Martens

Frost-Study & Curry Company

Contractor

COMPLETED

SECTION PLAT

1221 Ft. from N. Line

\_\_\_\_\_ Ft. from S. Line

330 Ft. from E. Line

\_\_\_\_\_ Ft. from W. Line

			o

Location \_\_\_\_\_

Hunter

Rig up \_\_\_\_\_

Drilling and Remarks:

Swab 500 Be  
in 6 Hours.

RECORD

Cased \_\_\_\_\_ in. \_\_\_\_\_ ft.

Sand 3448-3480

Gas \_\_\_\_\_

Oil \_\_\_\_\_

Total Depth 3480

PRODUCTION

1st 24 hrs. Nat. \_\_\_\_\_

1st 24 hrs. after shot \_\_\_\_\_

Gas \_\_\_\_\_ Cu. Ft.

Dry Hole \_\_\_\_\_

Abandoned \_\_\_\_\_

Date

MAR 2 2 1933

CHAS. L. SHERWOOD

192

Scout