

Harvey

Form 51-5M-11-31-Valace

Map No. KANSAS Sec. 19

Twp. 22

R. 3^w


Well No. 2- Martens

Farm

Mabee & Shell

Company

NORTH

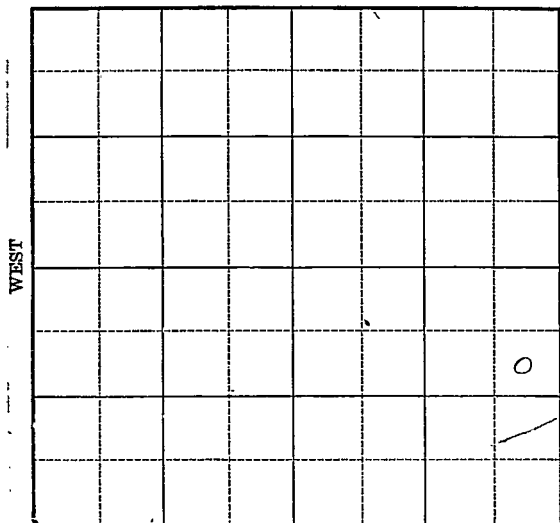

SOUTH

Ow 50-

Location

Drilling Remarks

Rig Up

Drilling Remarks

RECORD

Cased in. ft.

Sand

Gas

Oil

Total Depth

PRODUCTION

1st 24 hrs. Nat.

1st 24 hrs. after shot

Gas cu. ft.

Dry Hole

Abandoned

Map No. KANSAS Sec. 19 Twp. 22 R. 3^w

Well No. 2-Martens Farm
Mabee & O'Neil Company


NORTH

990 Ft. from N. Line

_____ Ft. from S. Line

330 Ft. from E. Line

_____ Ft. from W. Line

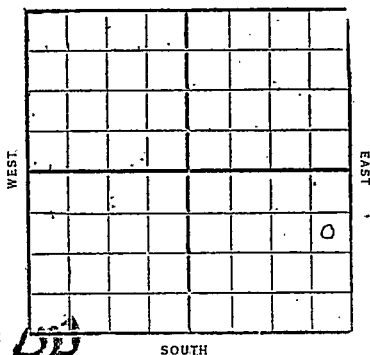

1932

Ow 55

Date

REPORT

10/12

Loc

10/19

10/26

Rig

11/2

15"-280

drlg 800'

11/9

" 2025'

11/16

" 3000'

11/23

Top Chat 3192

Perm 8" 3197

11/30

Correction 3198 = 3192

First oil 3215-20

TD 3225

flow 100 bbl 1 hr

12/7

TD 3225' shut in

bedg tankage

12/14

12/21

TD 3225

flow 362 bbl 1st hr and

200 bbl in 1/2 hour on Dec 17

45" back pressure

(over)

12/28- Cased 8" 3197

Chat 3192-3225'

TD 3225'

First oil 3215-20

flow 562 bbl 1 1/2 hr
shut in
Comp.

1933 O W D D.

7/19- Drilling Deeper

7/26 B. Mitt 3352 Tap Hunton 3457

T.D. 3459 4 1/2"

8/2 Cement 6" 3457'

8/9 Hunton 3457

T. D. 3473

600 bbls

COMPLETED

1934 O W D D

2/21 - Drilling Deeper

2/1- 95 3481 1000 Gal acid

Pump 55 Bbls per hr 5 hrs
after acid.

3/7 95 3481 Pump 330

Bbls 6 hrs.

COMPLETED

Harvey

43 KANSAS

Map No. _____ Sec. 19 Twp. 22 R. 3

Well No. 2 Martens

Mabee & Shep Company

Contractor

FIRST REPORTS

990 Ft. from N. Line

_____ Ft. from S. Line

330 Ft. from E. Line

_____ Ft. from W. Line

SECTION PLAT

Location ✓

Rig up

Drilling and Remarks:

RECORD

Cased _____ in., _____ ft.

Sand _____

Gas _____

Oil _____

Total Depth _____

PRODUCTION

1st 24 hrs. Nat. _____

1st 24 hrs. after shot _____

Gas _____ Cu. Ft.

Dry Hole _____

Abandoned _____

Date

OCT 12 1932

192 CHAS. L. SHERWOOD

Scout

43 KANSAS Harvey
 Map No. Sec. 19 Twp. 22 R. 3
 Well No. 2 Martens
 Maher & Wheeler Company

Contractor

COMPLETED

990 Ft. from N. Line

Ft. from S. Line

330 Ft. from E. Line

Ft. from W. Line

SECTION PLAT

			0

Location

Rig up

Drilling and Remarks:

101 DI 3215-20

Flow 562 bbls

1 1/2 Hours.

Shut in.

RECORD

Cased 8 in., 3197 ft.

Sand Hat 3198-3225

Gas

Oil

Total Depth 3225

PRODUCTION

1st 24 hrs. Nat.

1st 24 hrs. after shot

Gas Cu. Ft.

Dry Hole

Abandoned

Date

DEC 23 1932

CHAS. L. SHERWOOD

192

Scout

Map No. 43 Sec. 19 Twp. 22 R. 3W

Well No. 2 - Martens

Mabe & Shell Company

Contractor

SECTION PLAT


990 Ft. from N. Line

_____ Ft. from S. Line

330 Ft. from E. Line

_____ Ft. from W. Line

FIRST REPORTS

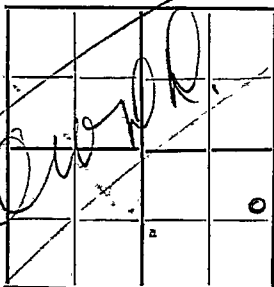

Location _____

Rig up _____

Drilling and Remarks:

O.T. N. 3225

Rig

RECORD

Cased _____ in., _____ ft.

Sand _____

Gas _____

Oil _____

Total Depth _____

PRODUCTION

1st 24 hrs. Nat. _____

1st 24 hrs. after shot _____

Gas _____ Cu. Ft.

Dry Hole _____

Abandoned _____

Date

7/19/33 Oval Mannesbach

Map No. 43 Sec. 19 Twp 22 R. 3W

Well No. 2 - Martens
Mabe & Shell Company

Contractor

SECTION PLAT

990 Ft. from N. Line

_____ Ft. from S. Line

990 Ft. from E. Line

_____ Ft. from W. Line

COMPLETED

			0

Location _____

Rig up _____

Drilling and Remarks:

600 fms

RECORD

Cased _____ in., _____ ft.

Sand Hunter 3457

Gas _____

Oil _____

Total Depth 3473

PRODUCTION

1st 24-hrs. Nat. _____

1st 24-hrs. after shot _____

Gas _____ Cu. Ft.

Dry Hole _____

Abandoned _____

Date

8/9/33 O. Mannich Scout

Map No. 413 Sec. 19 Twp. 22 R. 3W
 Well No. 2- Martens
Mabee & Shell Company

Contractor

SECTION PLAT

FIRST REPORT

990 Ft. from N. Line

_____ Ft. from S. Line

330 Ft. from E. Line

_____ Ft. from W. Line

			0

Owob

Location _____

Rig up _____

Drilling and Remarks:

OTO 3473
Base Hunton 3478
T. O. 3481
no increase
1000 gal acid
W. O. Ft.

RECORD

Cased _____ in., _____ ft.

Sand _____

Gas _____

Oil _____

Total Depth _____

PRODUCTION

1st 24 hrs. Nat. _____

1st 24 hrs. after shot _____

Gas _____ Cu. Ft.

Dry Hole _____

Abandoned _____

Date

2-21-34, 192 O. Marnuech Scout

Map No. 43 Sec. 19 Twp. 22 R. 3WWell No. 2-MartensMabee & Shell Company

Contractor

SECTION PLAT

990 ~~1000~~

Ft. from N. Line

Ft. from S. Line

330 Ft. from E. Line

Ft. from W. Line

			0

Location

Rig up

Drilling and Remarks:

Pump 330 oil
6 hrs

RECORD

Cased _____ in., _____ ft.

Sand _____

Gas _____

Oil _____

Total Depth 3481

PRODUCTION

1st 24 hrs. Nat. _____

1st 24 hrs. after shot _____

Gas _____ Cu. Ft.

Dry Hole _____

Abandoned _____

Date

3-7-34 192 O. Mennschick Scout