

Map No. _____ Sec. 19 Twp. 22 R. 3W


Well No. 4 Martens Farm _____
Skelly oil Company _____

_____ Ft. from N. Line

594 Ft. from S. Line

1058 Ft. from E. Line

_____ Ft. from W. Line

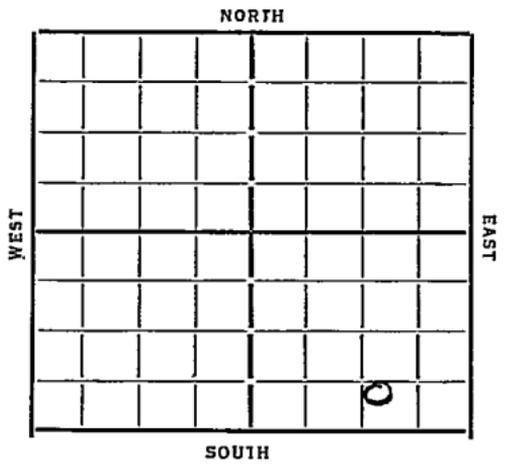

Date
1933

REPORT

7/12 moving in
7/19 12" 445 W.O.C.
7/26 drly 2448'
8/2 Top Chat 3157 Haly 3280
8/9 Top Huntow 3401 Top Viola 3525
 7" 3529 Reat
8/17 —
8/22 Wilson 3559 - 3569 T.D.
 . 566 bbls

COMPLETED

Harvey
 Map No. _____ Sec. 19 Twp. 22 R. 3W

43
 Well No. 4 Martens

Skelly oil _____ Company

_____ Contractor

SECTION PLAT

_____ Ft. from N. Line

594 Ft. from S. Line

1058 Ft. from E. Line

_____ Ft. from W. Line

FIRST REPORTS

			o

Location _____

Rig up _____

Drilling and Remarks:

moving in

RECORD

Cased _____ in., _____ ft.

Sand _____

Gas _____

Oil _____

Total Depth _____

PRODUCTION

1st 24 hrs. Nat. _____

1st 24 hrs. after shot _____

Gas _____ Cu. Ft.

Dry Hole _____

Abandoned _____

Date

7/12/33 192 _____ Scout

Map No. 43 Sec. 19 Twp. 22 R. 3W

Well No. 4 - Martens

Spelly Company

Contractor

COMPLETED

SECTION PLAT

..... Ft. from N. Line

594 Ft. from S. Line

1058 Ft. from E. Line

..... Ft. from W. Line

Location.....

Rig up.....

Drilling and Remarks:

506 bbls

RECORD

Cased..... in., ft.

Sand Wilcox 3559

Gas.....

Oil.....

Total Depth 3569

PRODUCTION

1st 24 hrs. Nat.....

1st 24 hrs. after shot.....

Gas..... Cu. Ft.

Dry Hole.....

Abandoned.....

Date

8/23/33 O. W. Mann Scout