

Harvey


KANSAS

Form 51-5M-11-31-Page

Map No. Sec. 19 Twp. 22 R. 3W

Well No. 5 Martins Farm

NORTH Sinclair Prairie Company

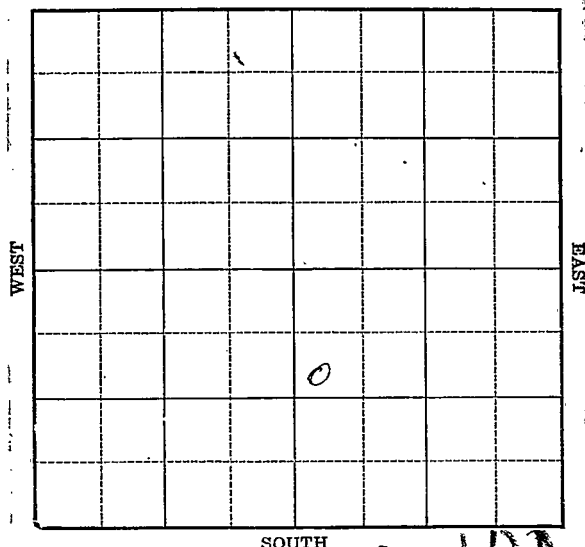

Location

Drilling Remarks

Rig Up

Drilling Remarks

RECORD

Cased in. ft.

Sand

Gas

Oil

Total Depth

PRODUCTION

1st 24 hrs. Nat.

1st 24 hrs. after shot

Gas cu. ft.

Dry Hole

Abandoned

Map No. _____ Sec. 19 Twp. 22 R. 3W


Well No. 5 martens Farm
P. & F. Sinclair-Prairie Company

990 Ft. from N. Line

_____ Ft. from S. Line

_____ Ft. from E. Line

330 Ft. from W. Line

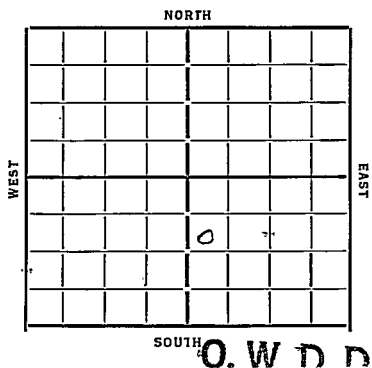

Date 1933

REPORT

8/2 Reg

8/19 12" - 410 - W.D., C.

8/17 drly 3450'

8/22 Top Chat 3137-8' 3143 T.D. 3145 Perot

8/30 Base Hunt 3277 T.D. 3318 1/2 Perot 6"

9/6 2. H. 3384-3405 - 2700' oil - swell
19 bbls 6 hrs - 1000 gal acid - swell
40 bbls 1 hr.

9/13 Huntton 3384
T.D. 3407 1/2
pump 720 bbls

COMPLETED

O. W. D. D.

1933

12/27 Drilling Deeper

1/4 Base Huntton 3405
Viola 3516
Wilcox 3530-48

4/11 Plug Back to 3540
shot 20 gals. C.O. no test

1/17 —

(over)

1/24- Wilcox 3530
T. D. 3548
P.B. to 3540
441 oil
250 water

COMPLETED

1936 O. W. D. D

3/11 U R 6" to deepen
3/13 --

3/20- T. Sil. 3624- T.D. 3628 S.D.

3/27- T.D. 3633' HFW.- Fishing tools.

4/2- T.D. 3633' Fishing.

4/10-6"@ 3377' Fishing bailer. 3633'

4/16- Plugged back to 3425'

4/23-PB to 3415'

4/30-3409' Cement.

5/7-Plugged back to 3175' S.D.

5/13/36- Sil. 3624'.

T.D. 3633'.

D&A

ABANDONED

Map No. 43 Sec. 19 Twp. 22 R. 3W

Well No. 5-Martens

P & K Company

Contractor


SECTION PLAT

990 Ft. from N. Line

_____ Ft. from S. Line

_____ Ft. from E. Line

330 Ft. from W. Line

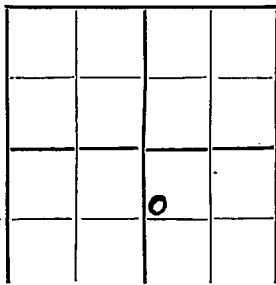

FIRST REPORTS

Location _____

Rig up _____

Drilling and Remarks:

Rig

RECORD

Cased _____ in., _____ ft.

Sand _____

Gas _____

Oil _____

Total Depth _____

PRODUCTION

1st 24 hrs. Nat. _____

1st 24 hrs. after shot _____

Gas _____ Cu. Ft.

Dry Hole _____

Abandoned _____

Date

8/7/33 192 Oval Mannick Scout

Harvey
Map No. 43 Sec. 19 Twp. 22 R. 3W

Well No. 5 - Martins

J & R Company

Contractor

SECTION PLAT

990 Ft. from N. Line

 Ft. from S. Line

 Ft. from E. Line

330 Ft. from W. Line

COMPLETED

		0	

Location

Rig up

Drilling and Remarks:

720 bbls
pump

RECORD

Cased in., ft.

Sand Hunter 3384

Gas

Oil

Total Depth 3407 1/2

PRODUCTION

1st 24 hrs. Nat.

1st 24 hrs. after shot

Gas Cu. Ft.

Dry Hole

Abandoned

Date

9/13/33 O. Mannick Scout

Map No. 438 Sec. 19 Twp. 22 R. 3W

Well No. 5- Martens

PT R Company

Contractor

FIRST REPORTS

SECTION PLAT

990 Ft. from N. Line

..... Ft. from S. Line

..... Ft. from E. Line

330 Ft. from W. Line

CWZ D

		0	

Location.....

Rig up.....

Drilling and Remarks:

CTD 3407 1/2

Rig up

RECORD

Cased.....in.,ft.

Sand.....

Gas.....

Oil.....

Total Depth.....

PRODUCTION

1st 24 hrs. Nat.....

1st 24 hrs. after shot.....

Gas.....Cu. Ft.

Dry Hole.....

Abandoned.....

Date

12-27-33 192

O. Mannschick Scout

Map No. 43 Sec. 19 Twp. 22 R. 3WWell No. 5-MartensP & R Company

Contractor


COMPLETED

SECTION PLAT

990 Ft. from N. Line

Ft. from S. Line

Ft. from E. Line

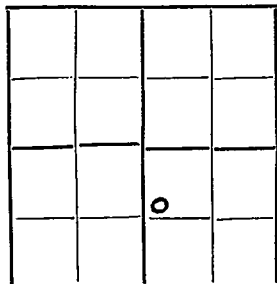330 Ft. from W. Line

Location

Rig up

Drilling and Remarks:

P. B 3540441 oil
150 water**RECORD**

Cased _____ in., _____ ft.

Sand Wilcox 3530

Gas _____

Oil _____

Total Depth 3548**PRODUCTION**

1st 24 hrs. Nat. _____

1st 24 hrs. after shot _____

Gas _____ Cu. Ft.

Dry Hole _____

Abandoned _____

Date

1-24-34 192 C. Mannsich Scout

KANSAS

Map No. 43 Sec. 19 Twp. 22 R. 3WWell No. 5-MartensLincoln-Prairie Company

Contractor

SECTION PLAT

		0	

Owd

990 Ft. from N. Line

Ft. from S. Line

Ft. from E. Line

330 Ft. from W. Line

FIRST REPORTS

Location

Rig up

Drilling and Remarks:

OTN 3548

P.B. 3546

2 1/2" 6" to deeper

RECORD

Cased.....in.,ft.

Sand.....

Gas.....

Oil.....

Total Depth.....

PRODUCTION

1st 24 hrs. Nat.....

1st 24 hrs. after shot.....

Gas.....Cu. Ft.

Dry Hole.....

Abandoned.....

Date

3-11-36 192

ORVAL MANNSCHRECK

Scout

KANSASMap No. J43 Sec. 19 Twp. 22 R. 3 WWell No. 5 MartensSinclair Prairie Company

Contractor

SECTION PLAT

		0	

990 Ft. from N. Line

_____ Ft. from S. Line

_____ Ft. from E. Line

320 Ft. from W. Line**ABANDONED**

Location _____

Rig up _____

Drilling and Remarks:

Oil 3624IXA**RECORD**

Cased _____ in., _____ ft.

Sand _____

Gas _____

Oil _____

Total Depth 3633**PRODUCTION**

1st 24 hrs. Nat. _____

1st 24 hrs. after shot _____

Gas _____ Cu. Ft.

Dry Hole _____

Abandoned _____

Date

1935

19

"S. L. F. S"

Scout