

Harvey


Form 51-5M-11-31-Palace

Map No. KANSAS Sec. 19 Twp. 22 R. 3W

Well No. 7 martens Farm

P. + R. Company

NORTH

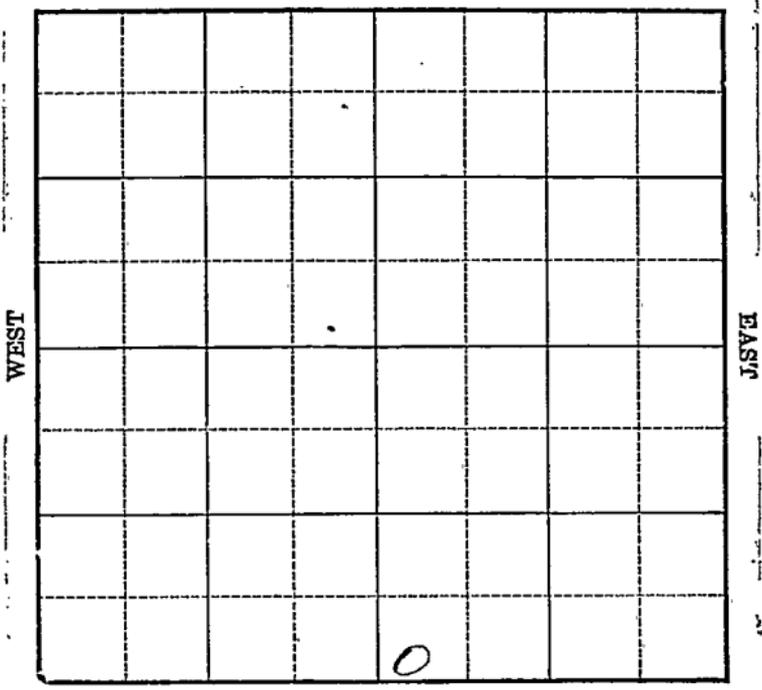

SOUTH

Location _____

Drilling Remarks _____

Rig Up _____

Drilling Remarks _____

RECORD

Cased _____ in. _____ ft.

Sand _____

Gas _____

Oil _____

Total Depth _____

PRODUCTION

1st 24 hrs. Nat. _____

1st 24 hrs. after shot _____

Gas _____ cu. ft.

Dry Hole _____

Abandoned _____

Harvey

Map No. KANSAS Sec. 19 Twp 22 R. 3W


Well No. 7-martens Farm
P. & R. Company

_____ Ft. from N. Line

330 Ft. from S. Line

_____ Ft. from E. Line

330 Ft. from W. Line

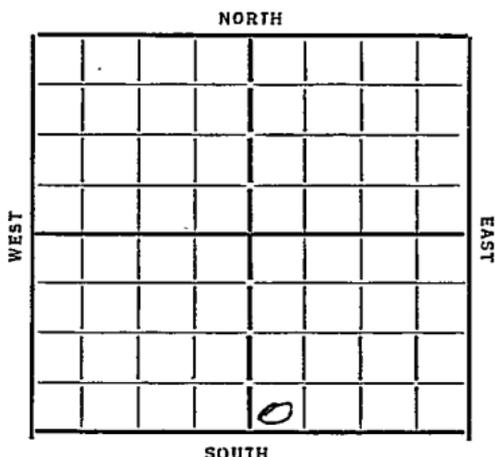

Date
1933

REPORT

9/13 Reg
7/20 15" - 368' 9/29 relog 2549
10/15 Baro Meter 3235 July 3302
10/11 8" 3321 - T. Hunter 3334 - show oil
10/18 B. Hunter 3364 - T.D. 3367
treated with 1000 gal acid -
no test yet.
10/25 Go to Wilcox - T.D. 3455 casing
11/1 Top Wilcox 3498 - 3532
T.D. 3542 - 2200' oil
11/8 Swab 565 bbls in 12 hrs
set gas engine
11/15 11/22 11/29
12/6 Wilcox 3498 T.D. 3542
Potential 900 bbls
COMPLETED

Map No. 43 Sec. 19 Twp. 22 R. 3W

Well No. 7 Martens

P + R Company

Contractor

SECTION PLAT

Ft. from N. Line

330 Ft. from S. Line

Ft. from E. Line

330 Ft. from W. Line

FIRST REPORTS

Location.....

Rig up.....

Drilling and Remarks: Rig

RECORD

Cased..... in., ft.

Sand.....

Gas.....

Oil.....

Total Depth.....

PRODUCTION

1st 24 hrs. Nat.....

1st 24 hrs. after shot.....

Gas..... Cu. Ft.

Dry Hole.....

Abandoned.....

Date

9/13/33 192

O. Manschreck Scout

Map No. 43 Sec. 19 Twp. 22 R. 3W

Well No. 7-Martens

P+R Company

Contractor

COMPLETED

SECTION PLAT

		0	

.....Ft. from N. Line

330 Ft. from S. Line

.....Ft. from E. Line

330 Ft. from W. Line

Location.....

Rig up.....

Drilling and Remarks:

*potential
909*

RECORD

Cased.....in.,.....ft.

Sand oil of 3498

Gas.....

Oil.....

Total Depth 3542

PRODUCTION

1st 24 hrs. Nat.....

1st 24 hrs. after shot.....

Gas.....Cu. Ft.

Dry Hole.....

Abandoned.....

Date

12-6-33 192 O. Mansch Scout