


Harvey

Map No. **KANSAS** Sec. 19 Twp. 22 R. 3^w

Well No. 6 Martens Farm _____
Mabe & Shell Company

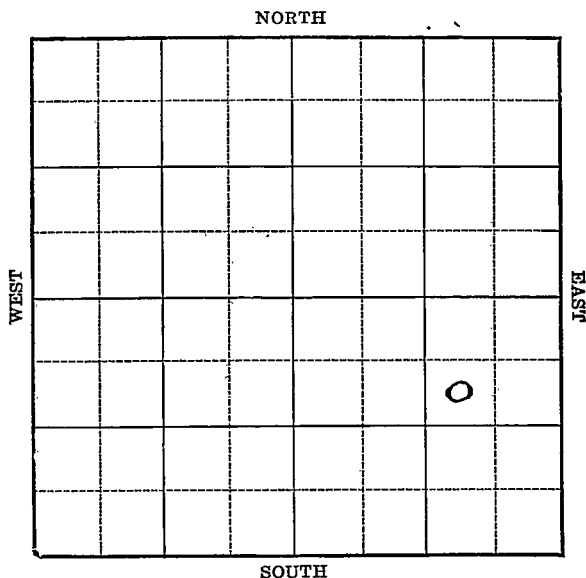

Location _____
Drilling Remarks _____

Rig Up _____
Drilling Remarks _____

RECORD

PRODUCTION

Cased _____ in. _____ ft.

Sand _____

Gas _____

Oil _____

Total Depth _____

1st 24 hrs. Nat. _____

1st 24 hrs. after shot _____

Gas _____ cu. ft.

Dry Hole _____

Abandoned _____

Harvey


KANSAS

Map No. _____ Sec. 19 Twp 22 R. 37

Well No. 6- Martens Farm _____

Mabe & Shell Company _____

NORTH

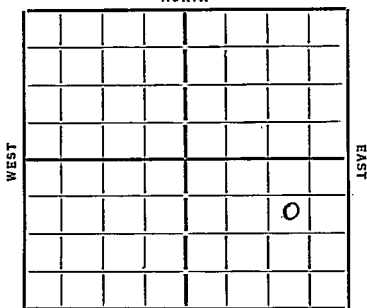

825 Ft. from N. Line

_____ Ft. from S. Line

990 Ft. from E. Line

_____ Ft. from W. Line

Date 1934

REPORT

1/31 Rig
2/9 —
2/14 Delg 695
2/23 " 2025
3/1 Chat 3165 Coring
3/8 Rust
3/15 7" 3431 Newton 3432
 TD 3458 wash 55 Bbls
 per hr.
3/21 Newton 3432 TD 3458
 15-88 Bbls.

COMPLETED

Map No. 43 Sec. 19 Twp. 22 R. 3W

Well No. 6 - Martens

Mabee & Shell Company

Contractor

FIRST REPORTS

SECTION PLAT

825 Ft. from N. Line

..... Ft. from S. Line

990 Ft. from E. Line

..... Ft. from W. Line

			o

Location.....

Rig up.....

Drilling and Remarks:

Rig

RECORD

Cased..... in., ft.

Sand.....

Gas.....

Oil.....

Total Depth.....

PRODUCTION

1st 24 hrs. Nat.....

1st 24 hrs. after shot.....

Gas..... Cu. Ft.

Dry Hole.....

Abandoned.....

Date

1-31-34 192

O. Manschick
Scout

Map No. 43 Sec. 19 Twp. 22 R. 3W

Well No. 6. Martens

Mabee + Shell Company

Contractor

COMPLETE

SECTION PLAT

			0

855 Ft. from N. Line

_____ Ft. from S. Line

990 Ft. from E. Line

_____ Ft. from W. Line

Location _____

Rig up _____

Drilling and Remarks:

1588 fbls

RECORD

Cased _____ in., _____ ft.

Sand Hutton 3437

Gas _____

Oil _____

Total Depth 3458

PRODUCTION

1st 24 hrs. Nat. _____

1st 24 hrs. after shot _____

Gas _____ Cu. Ft.

Dry Hole _____

Abandoned _____

Date

3/21/37 19 O. Manschuet Scout