



Harvey

Map No. KANSAS Sec. 19 Twp. 22 R. 3<sup>w</sup>

Well No. 6 Matene Farm


Grost et al Company

\_\_\_\_\_ Ft. from N. Line

1419 Ft. from S. Line

887 Ft. from E. Line

\_\_\_\_\_ Ft. from W. Line

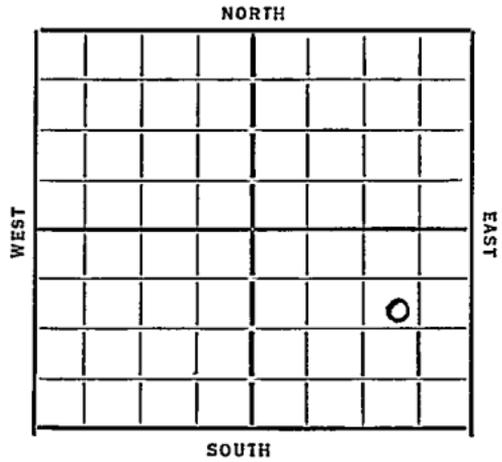

Date  
1934

REPORT

2/14 Rig Rot  
2/23 15" 295  
3/1 Drly 2195  
3/8 " 3030  
3/15 7D 3436 Cen 6" Rust  
3/22 \_\_\_\_\_  
4/4 Huntton 3434 1/2 7D 3463  
 1000 acid 245 oil 2 1/2 Mil gal

COMPLETED

Map No. 43 Sec. 19 Twp. 22 R. 3W

Well No. 6- Martens  
Ofrost et al Company

Contractor

**FIRST REPORT**

**SECTION PLAT**

..... Ft. from N. Line

1419 Ft. from S. Line

887 Ft. from E. Line

..... Ft. from W. Line

			0

Location .....

Rig up .....

Drilling and Remarks:

*Rig Rat*

**RECORD**

Cased: ..... in., ..... ft.

Sand .....

Gas .....

Oil .....

Total Depth .....

**PRODUCTION**

1st 24 hrs. Nat. ....

1st 24 hrs. after shot .....

Gas ..... Cu. Ft.

Dry Hole .....

Abandoned .....

Date

2-14-34 192 O. Mannschick Scout

