

Harvey

Map No. KANSAS Sec. 19 Twp 22 R. 3W


Well No. 7 Mattens Farm
Mabee & Shell Company

_____ Ft. from N. Line

1240 Ft. from S. Line

1240 Ft. from E. Line

_____ Ft. from W. Line

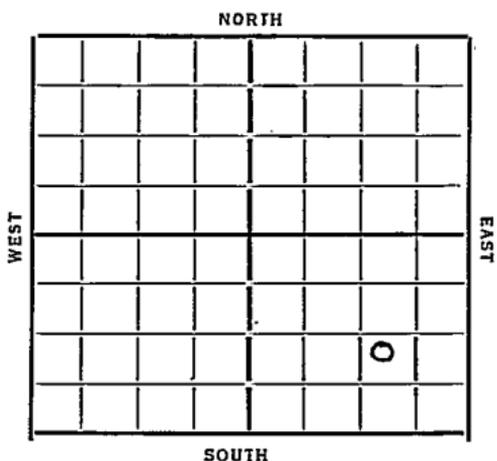

Date
1934

REPORT

2/14 Building Rig
2/23 — 3/1 —
3/8 Run 15" 495
3/15 Dwg 1800
3/22 " 3030
3/29 Chat 3184 B. Miss 3335
7" 3425 Hutton 3424 Ruct
4/5 5 m Gas 3424-26 Dly.
4/12 S.g. 3430 S.O. 3438 T.D. 3475
40 gte 3438-66 1000 Gal acid
4/19 Pump 50 Bbls per hr.
4/25 Hutton 3424 T.D. 3475
1000 acid 1355 oil

COMPLETED

Map No. 43 Sec. 19 Twp. 22 R. 3W

Well No. 7 - Martens

Makee & Shell Company

Contractor

FIRST REPORT

SECTION PLAT

.....Ft. from N. Line

1240 Ft. from S. Line

1240 Ft. from E. Line

.....Ft. from W. Line

RECORD

Location.....

Cased.....in.,ft.

Rig up.....

Sand.....

Drilling and Remarks:

Gas.....

Oil.....

Total Depth.....

BR

PRODUCTION

1st 24 hrs. Nat.....

1st 24 hrs. after shot.....

Gas.....Cu. Ft.

Dry Hole.....

Abandoned.....

Date

2-14-34 192 O. Mammerschlag Scout

Map No. 43 Sec. 19 Twp. 22 R. 3W

Well No. 7-Martens

Mahoe & Shell Company

Contractor

COMPLETED

SECTION PLAT

			0

_____ Ft. from N. Line

1240 Ft. from S. Line

1240 Ft. from E. Line

_____ Ft. from W. Line

Location _____

Rig up _____

Drilling and Remarks:

1000 acid

1355
oil

RECORD

Cased _____ in., _____ ft.

Sand Hanton 3424

Gas _____

Oil _____

Total Depth' 3475

PRODUCTION

1st 24 hrs. Nat. _____

1st 24 hrs. after shot _____

Gas _____ Cu. Ft.

Dry Hole _____

Abandoned _____

Date

4-25-34

19

Scout