


Pawnee KANSAS

DX 78-1

Section 19 Township 22 Range 18W
Well No. 1 Higgins "A"
Company G-M-R Oil

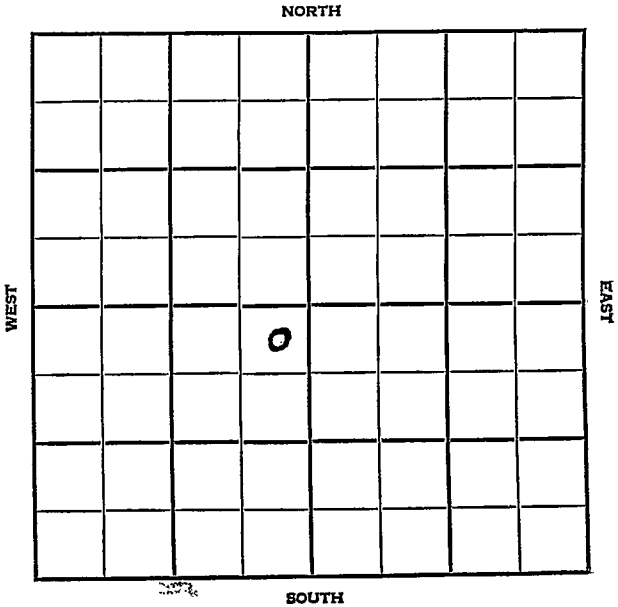

Pawnee KANSAS

SEC.	TWP.	R.
19	22	18W

WELL NO.

1 Higgins "A"

FARM

COMPANY

G-M-R Oil

CONTRACTOR

G-M-R


Wildcat

330 Ft. from N. Line

Ft. from S. Line

330 Ft. from E. Line

Ft. from W. Line

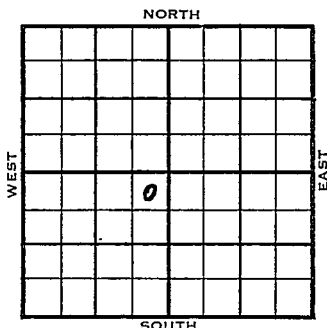

NE NE SW

	ELEVATION	REPORT
1954	2107'	

8/4 Spud 7-30-54
8" @ 255'
Drlg. 2808'

8/25 Spud 7-30-54 D & A TD 4698
8" @ 255' Br. lime 3761 Lans 3775
Miss 4296 Kh. 4400
DST 4406-21 open 1 hr rcc 20' mud
240# Simp. 4602 Arb. 4648
TD 4698
Schl tops: Heeb 3680' Br lime 3765
Lans 3775 Cong. 4270 Miss 4296
Kh. 4350 Viola 4468 Simp. 4602
Arb. 4648'
TD 4698' D & A


ABANDONED

County, Pawnee State Kansas
 Sec. 19 (Blk.) 22 (Sur.) 18W Map No.

Operator G-M-R Oil

Well No. 1 Farm Higgins "A"

Elev. Location NE NE SW

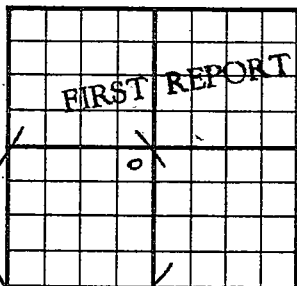

330 Ft. From N Line SW

330 Ft. From E Line Quarter

1st. Report AUG 4 1954

Completion

Remarks


G-M-R - Contr.

Spudding Date 7-30-54

Drlg. Data Wildcat

8" @ 255 drlg. 2808

J. G. McGEHEE

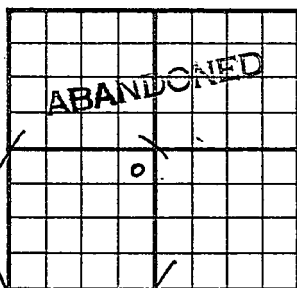County Pawnee State KansasSec. 19 (Blk.) 22 (Sur.) 18W Map No.Operator G-M-R OilWell No. 1 Farm Higgins "A"Elev. 2107 Location NE NE SW330 Ft. From N Line SW330 Ft. From E Line Quarter1st. ReportCompletion AUG 25 1954Remarks WildcatG-M-R - Contr.Spudding Date 7-30-54Drlg. Data D & A TD 46988" @ 255 Br. lime 3761 Lans. 3775Miss. 4296 Kh. 4400 DST 4406-21open 1 hr. Rec. 20' mud 240#Simp. 4602 Arb. 4648 TD 4698SCHLUMBERGER TOPSHeeb. 3680 Br. lime 3765 Lans. 3775Cong. 4270 Miss. 4296 Kh. 4350Viola 4468 Simp. 4602 Arb. 4648TD 4698D & A

FABEN GILSTRAP