


Section 19 Township 22 Range 33W

Well No. #1 G. City Tract "C"

Company Texas Company

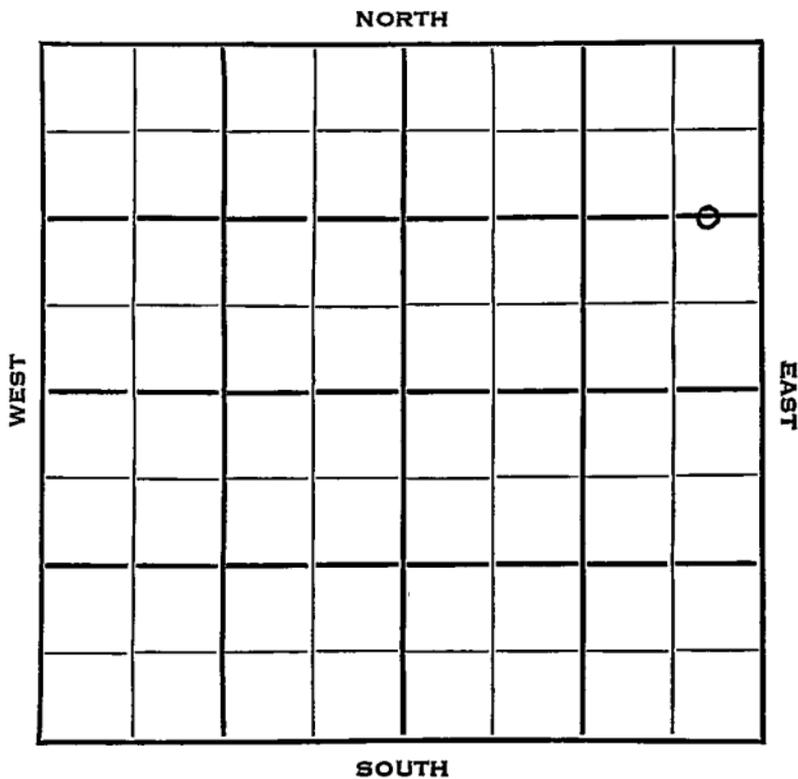

Finney KANSAS

SEC.	TWP.	R.
19	22	33W ✓

WELL NO. I G. City Tract "C" FARM

COMPANY Texas Company

CONTRACTOR


Hugoton Pool

1320 Ft. from N. Line

Ft. from S. Line

50 Ft. from E. Line

Ft. from W. Line

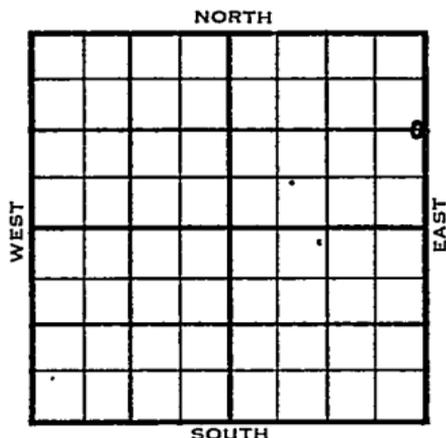

C E/2 E/2 NE

1954	ELEVATION 2907'	REPORT
------	--------------------	--------

- 2/17 Location
- 2/24 10" @ 509' w/375' sks
TD 2635'
Log 7" set
Hol 2504', Her 2531', Kr. 2554', Win 2590'
- 3/3 CO 2611
18/ 2591-2600 1000 A NS.
sq.
PB 2580
26/ 2536-49 20/ 2554-64 frac
- 3/24 Spud 2-17-54 Gas well TD 2635
10" @ 509 Hol. 2504 Her. 2531
Kri. 2554 Win. 2590 TD 2635
7" @ 2634 18/2591-2600 1000 A
PB 2580 26/2536-49 20/2554-64
frac. Comp. 3,468,000 gas.

COMPLETED

County Finney State Kansas

Sec. 19 (Blk. 22) (Sur. 33W) (Twp.) (Rge.) Map No.

Operator Texas Company

Well No. 1 Farm G. City Tract "C"

Elev. 2907 Location C E $\frac{1}{2}$ E $\frac{1}{2}$ NE

1320 Ft. From N Line NE

50 Ft. From E Line Quarter

Ist. Report

Completion MAR 24 1954

Remarks Hugoton Pool

Spudding Date 2-17-54

Drlg. Data Gas well TD 2635

10" @ 509 Hol. 2504 Her. 2531

Kri. 2554 Win. 2590 TD 2635 7" @ 2634

18/ 2591-2600 1000 A PB 2580

26/ 2536-49 20/ 2554-64 frac

Comp. 3,468,000 gas

J. G. McGEHEE