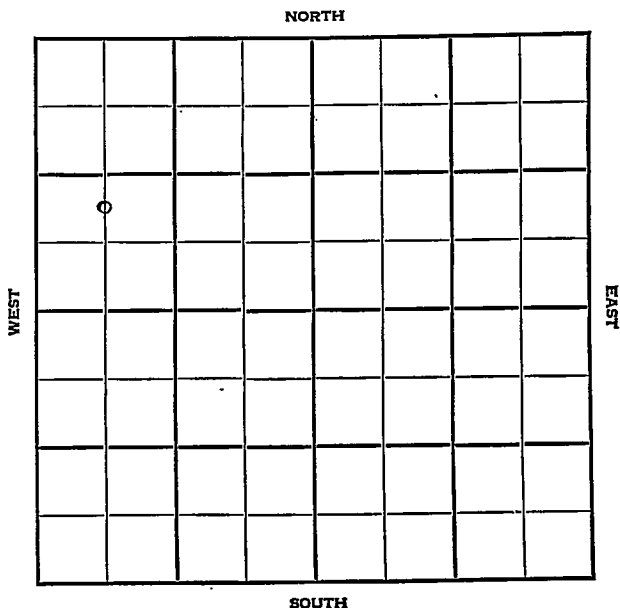


Section 2 Township 22 Range 13WWell No. #2BatmanCompany Phillips

KANSAS

Stafford

Sec. 2 Twp. 22 R. 13-W

Well No. #2 Batman Farm

Phillips Company

Drach Pool


 Ft. from N. Line

990' Ft. from S. Line

 Ft. from E. Line

660' Ft. from W. Line

C N L SW NW

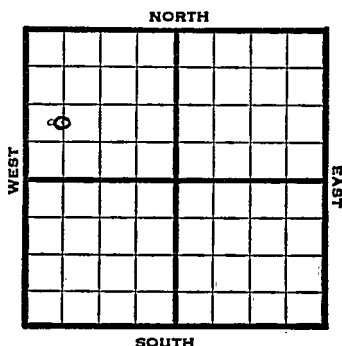

1947	Elev. 1885' REPORT
11/25	RUR
12/3	8" @ 412' Drlg. 2715'
12/10	Lansing 3364' Viola 3682' Arbuckle 3730' TD 3742'
12/17	Arbuckle 3726' TD 3772'
	ABANDONED

Map No. _____ Sec. 2 Twp. 22 R. 13W

Well No. 2 Batman

Phillips Company

FIRST REPORT

Contractor

C N L SW NW

SECTION PLAT

0			1

_____ Ft. from N. Line

990 Ft. from S. Line

_____ Ft. from E. Line

660 Ft. from W. Line

Stafford County

Location _____

Rig up _____

Drilling and Remarks:

R U R

RECORD

Cased _____ in., _____ ft.

Sand _____

Gas _____

Oil _____

Total Depth _____

PRODUCTION

1st 24 hrs. Nat. _____

1st 24 hrs. after shot _____

Gas _____ Cu. Ft.

Dry Hole _____

Abandoned _____

Date

NOV 25 1947

19

S. J. LEWIS

Scout

Map No. Q2 Sec. 2 Twp. 22 R. 13W

Well No. 2 Batman

Phillips Company

ABANDONED

Contractor

C N L SW NW

E 11883
SECTION PLAT

 Ft. from N. Line

990 Ft. from S. Line

 Ft. from E. Line

660 Ft. from W. Line

o			

Stafford County

Location

Rig up

Drilling and Remarks:

See 3726

RECORD

Cased in., ft.

Sand

Gas

Oil

Total Depth 8272

PRODUCTION

1st 24 hrs. Nat.

1st 24 hrs. after shot

Gas Cu. Ft.

Dry Hole

Abandoned

Date

DEC 17 1947 19

S. J. LEWIS Scout