


Section 2 Township 22 Range 11W

Well No. #2 Keenan

Company Sunray

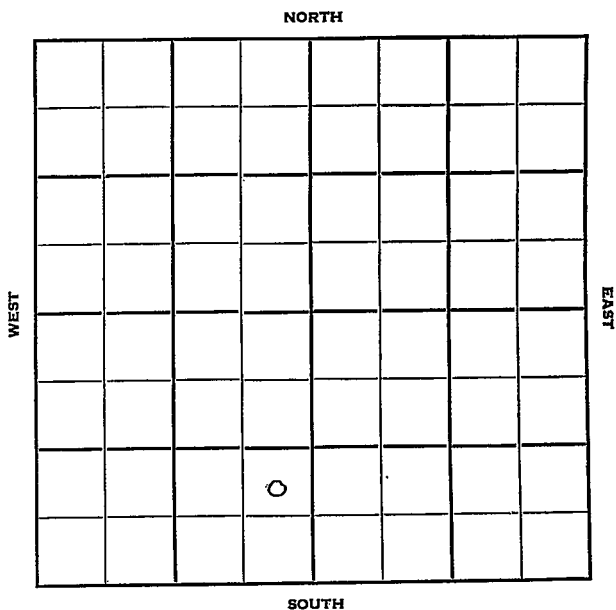

Sec. 2 Twp. 22 R. 14 W ✓

Well No. # 2 Keenan Farm

Sunray Company

Jackson Drlg. Contractor  
Smallwood Pool


\_\_\_\_\_ Ft. from N. Line

990 Ft. from S. Line

330 Ft. from E. Line

\_\_\_\_\_ Ft. from W. Line

NE SE SW

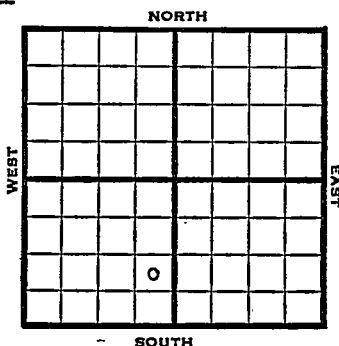

1951 Elev. 1935' REPORT

9/12 Location  
10/17 Spud 9-13-51  
Oil Well TD 3810  
8" @ 340  
Ians. 3418  
DST 3478-97 open 40 min  
Rec. 205' HO&GCM 90' oil, 5' wtr.  
DST 3533-50 open 20 min.  
Rec. 240' fluid, 180' ho & gcm  
Viola 3683 Simp. 3720 Arb. 3772  
DST 3773-78 open 1 hr.  
Rec. 105' oil TD 3810  
5" @ 3810 40/ 3543-52 2500A  
Comp. 195 BOPD 3% wtr.

3424  
1933  
-1483



