


Section 2 Township 22 Range 11W

Well No. #3 Keenan

Company Sunray

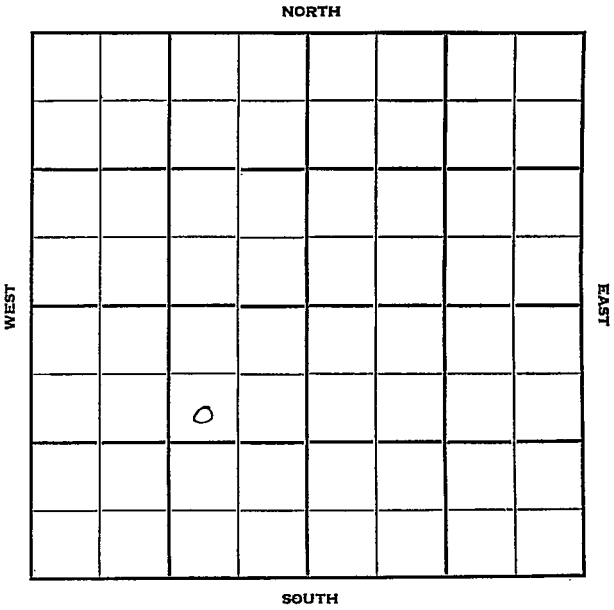

Stafford

KANSAS

Sec. 2 Twp. 22 R. 14 W

Well No. # 3 Keenan Farm

Sunray Company

Jackson Contractor

Smallwood


990 Ft. from N. Line

_____ Ft. from S. Line

990 Ft. from E. Line

_____ Ft. from W. Line

SW NE SW

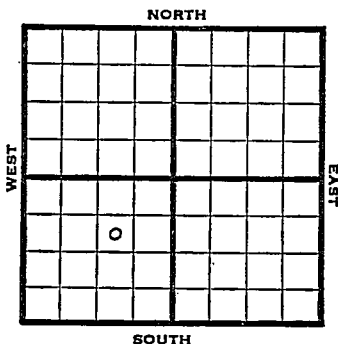

1951

Elev. 1935' REPORT

10/17

Spud 10-12-51
8" @ 340'
Drilling 1965'

11/14

Spud 10-12-51
Oil well TD 3783
8" @ 340
Br. lime 3414 Lans. 3425
DST 3488-3504 open 40 min.
Rec. 90' oily mud
DST 3539-53 open 1/2 hr.
Rec. 25' oil mud 303' gassy oil
Arb. 3780 Simp. 3740
5" @ 3782 TD 3783
CO to 3745 14/ 3545-52 2000 A
F/ 33 BOPH
Comp. 3000 BOPD

COMPLETED

County **Stafford** State **Kansas**Sec. **2** (Blk. Twp.) **22** (Sur. Rge.) **14W** Map No.Operator **Sunray**Well No. **3** Farm **Keenan**Elev. Location **SW NE SW**

FIRST REPORT							

990 Ft. From **N** Line **SW****990** Ft. From **E** Line QuarterIst. Report **OCT 17 1951**

Completion

Remarks

Jackson - Contr.Spudding Date **10-12-51**Drlg. Data **Small Wood****8" @ 340' Drlg. 1965****J. E. TYRA**

