


Section 2 Township 22 Range 1/W

Well No. #3 Kennan

Company Westgate-Greenland

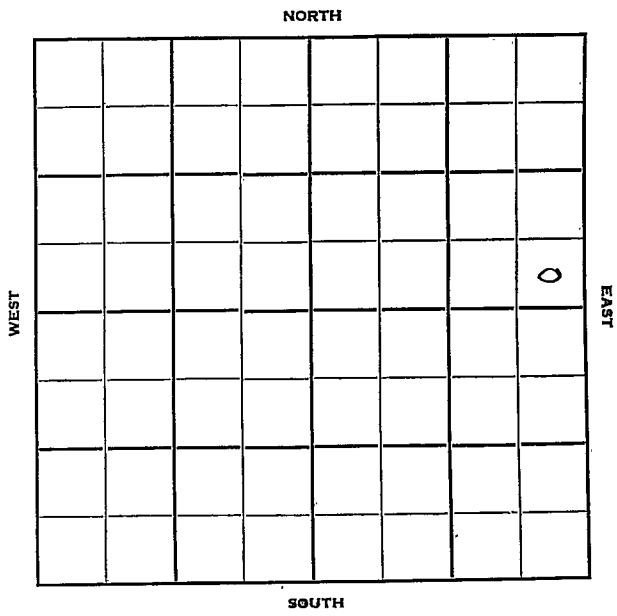

Stafford

Sec. 2 Twp. 22 R. 14W

Well No. #3 Keenan Farm

Westgate-Greenland Company

Jackson - Contr. Contractor

Smallwood


 Ft. from N. Line

330' Ft. from S. Line

330' Ft. from E. Line

 Ft. from W. Line

SE SE NE

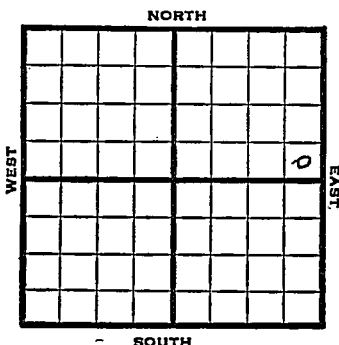

1952	Elev. 1937'	REPORT
5/21	RUR	
5/28	Anhy 814 10" @ 345 Drlg 3130'	
6/11	Heeb. 3292 Lans. 3430 Simp. 3730 RTD 3810 5" @ 3809 78/ 3770-88 1000 A S/ 6 Boph for 10 hr. POP	Br Li 3419 V 3690 Arb. 3768
6/18	NR	
6/25	"	
7/2	"	
7/9	"	
7/16	Spud 5-20-52 Oil Well TD 3810 10" @ 345 Anhy 814 Heeb. 3292 Br Lime 3419 Lans. 3430 DST 3489-3505 opn 1 hr. Rec. 30' mud 700# DST 3509-29 opn 1 hr. rec 15' mud 900# DST 3545-58 opn 1 hr. Rec. 110' oil 40' hocm 900# DST 3564-95 opn 1 hr. Rec. 115' sw 1050# BKC 3664 Viola 3690 Simp 3730 Arb. 3768 DST 3770-83 opn 1 hr. Rec. 70' hocm 630# TD 3810 5" @ 3809 78/3770-88 1000 A S/6 boph 10 hr. Comp. 173 bopd 12% wtr.	

COMPLETED

County **Stafford** State **Kansas**

Séc. **2** (Blk. Twp.) **22** (Sur. Rge.) **14W** Map No.

Operator **Westgate-Greenland**

Well No. **3** Farm **Keenan**

Elev. Location **SE SE NE**

LAST REPORT

330 Ft. From **S** Line **NE**

330 Ft. From **E** Line Quarter

Ist. Report **MAY 21 1952**

Completion

Remarks

Jackson - Contr.

Spudding Date

Drlg. Data **Smallwood**

RU

J. G. McGENEE

