


Section 2 Township 22 Range 11W

Well No. #1 Keenan

Company Sunray

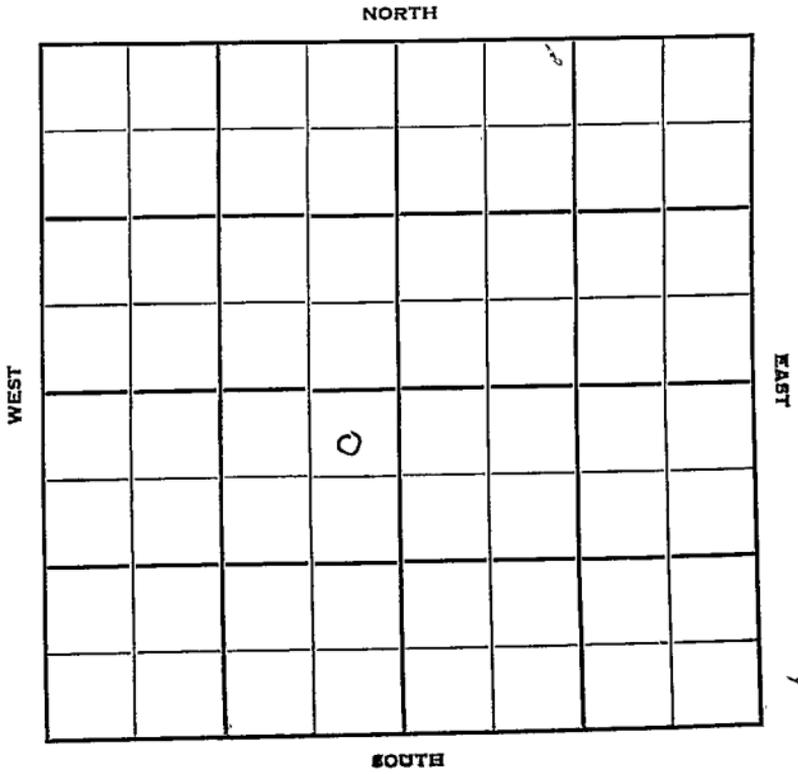

Sec. 2 Twp. 22 R. 14W

Well No. #1 Keenan Farm

Sunray Company

Jackson Drlg. - Contr. Contractor

Smallwood Pool


330' Ft. from N. Line

_____ Ft. from S. Line

330' Ft. from E. Line

_____ Ft. from W. Line

NE NE SW

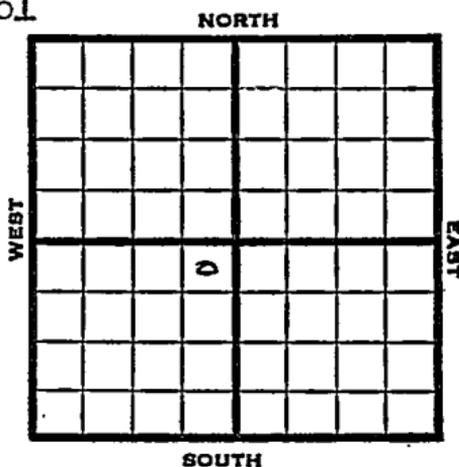

1951

Elv. 1937' REPORT

8/15 Cellar & Pits

9/19 Spud 8-19-51
Oil Well TD 3775
8" @ 335
KC 3418 BKG 3651
DST 3472-96 opn 40 min.
gas in 6 min. Rec. 2600' oil
DST 3534-45 opn 40 min. gas in 9 min.
Rec. 1800' gassy oil
Arb. 3771-75
5" @ 3773 40/3542-52 2 boph
2500 A F/140 bo 10 hr
Comp. BHB 3568 bopd

COMPLETED

County Stafford State Kansas

Sec. 2 (Blk. 22) (Sur. Rge.) E 4W Map No.

Operator Sunray

Well No. 1 Farm Keenan

Elev. Location NE NE SW

FIRST REPORT

0

330 Ft. From N Line SW

350 Ft. From W Line Quarter

Ist. Report AUG 15 1951

Completion

Remarks

Jackson Drlg. - Contr.

Spudding Date

Drlg. Data Smallwood Pool

Cellar & pits

J. E. TYRA


County Stafford State Kansas

Sec. 2 (Blk. 2 2) (Sur. Rge.) 14W Map No.

Operator Sunray

Well No. 1 Farm Keenan

Elev. 1937 Location NE NE SW

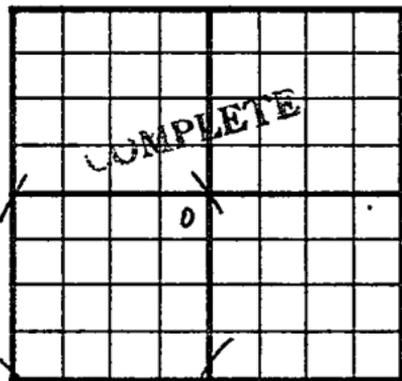

330 Ft. From N Line SW

330 Ft. From E Line Quarter

1st. Report

Completion SEP 19 1951

Remarks Smallwood Pool

Jackson D. lg. - Contr.

Spudding Date 8-19-51

Drilg. Data Oil well TD 3775

8" @ 335 KC 3418 B KC 3651 DST 3472-96

open 40 min. gas in 6 min. Rec. 2600' oi

DST 3534-45 open 40 min. gas in 9 min.

Rec. 1800' gassy oil Arb. 3771-75

5" @ 3773 40/ 3542-52 2 boph 2500 A

F/ 140 bo 10 hr. Comp. BHB 3568 bopd