


Section 2 Township 22 Range 14W

Well No. #2 Keenan

Company West gage-Greenland

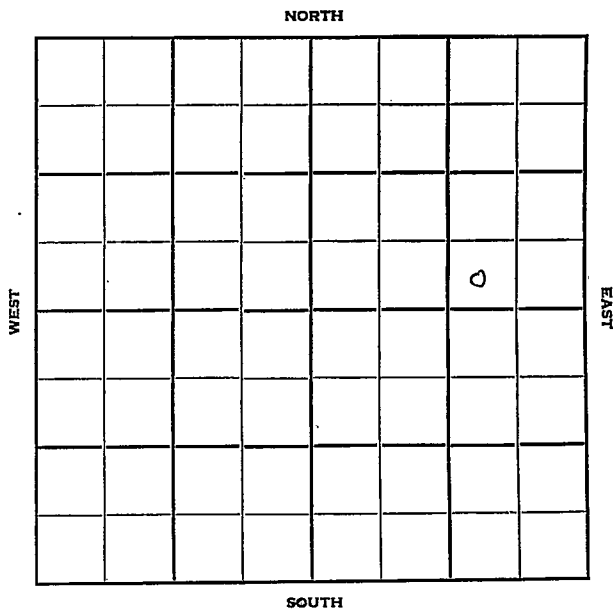

Stafford

KANSAS

Sec. 2 Twp. 22 R. 14 W

Well No. # 2 Keenan Farm

Westgate-Greenland Company

Contractor

Smallwood Pool


Ft. from N. Line

330 Ft. from S. Line

990 Ft. from E. Line

Ft. from W. Line

SW SE NE

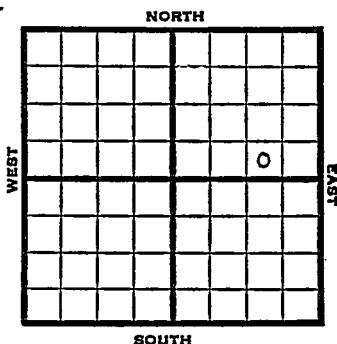

1951

Elev. 1935⁺ REPORT

9/26

MIR

1952

1/9

Spud 9-27-51

Oil Well Td 3805'

8" @ 340

Br li 3417 Ians. 3428

DST 3491-3504 open 1 hr.

Rec. 210⁺ VSOCSW

DST 3547-58 open 1 hr. Rec. 300⁺ OCM

DST 3608-19 open 1 hr. Rec. 15' OCM

B KC 3660 Viola 3695 Simp. 3735

Arb. 3779-3805

6" @ 3607 69/ 3542-56 1000 A

S/ 110 B0 3 hr.

Comp. 400 BOPD

COMPLETED

3779
1933
1844

Sec. 2 (Blk. Twp.) 22 (Sur. Rge.) 14W Map No.

Well No. **2** Farm **Keenan**

Elev.	Location	SW	SE	NE
-------	----------	----	----	----

0

FIRST REPORT

330 Ft. From S Line NE

990 Ft. From E Line Quarter

1st. Report SEP 26 1951

Completion

Remarks


Spudding Date

Drlg. Data Smallwood Pool

THE

J. E. TYRA

County Stafford State Kansas
 Sec. 2 (Blk. 22 (Sur. 14W Map No.
 (Twp.) (Rge.)
 Operator Westgate-Greenland
 Well No. 2 Farm Keenan
 Elev. 1935 Location SW SE NE

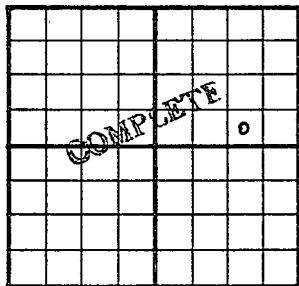

330 Ft. From S Line NE
990 Ft. From E Line Quarter
 1st. Report
 Completion JAN 9 1952
 Remarks Smallwood Pool

Spudding Date 9-27-51

Drlg. Data Oil well TD 3805
8" @ 340 Br. lime 3417 Lans. 3428
DST 3491-3504 open 1 hr. Rec. 210'
vsocsw DST 3547-58 open 1 hr.
Rec. 300' ocm DST 3608-19 open 1 hr.
Rec. 15' ocm B KC 3660 Viola 3695
Simp. 3735 Arb. 3779-3805 6" @ 3607
69/ 3542-56 1000 A S/ 110 bo 3 hr.
Comp. 400 bopd

J. E. TYRA