

Section 2 Township 22 Range 14WWell No. #1 KeenanCompany Sunray

NORTH

WEST

EAST

		0					

SOUTH

Stafford

KANSAS

Sec. 2 Twp. 22 R. 14 W

Well No. # 4 Keenan ☒ Farm

Sunray Company

Anschutz Drlg. Contractor

Smallwood Pool


Ft. from N. Line

330 Ft. from S. Line

990 Ft. from E. Line

Ft. from W. Line

SW SE SW

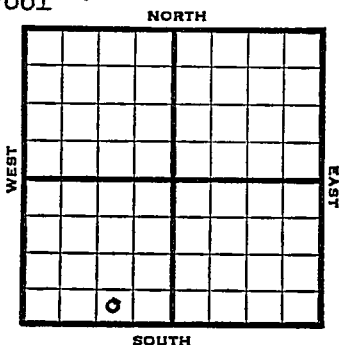

1952

Elev. 1935' REPORT

1/2
2/6

8" @ 344' WOC
Spud 12-30-51
Oil Well TD 3791
8" @ 344 Heeb. 3295
Br lime 3419 Lans. 3429
BKC 3660 Cong. 3689
Viola 3696 Simp 3730
Arb. 3786
DST 3787-91 opn 1 hr Rec. 15' oil &
mud TD 3791 5" @ 3787
Co to 3753 19/3547-63
Test 3/4 boph 2000 A S/20 boph
4 hr. Comp. 185 bopd

COMPLETED

County **Stafford** State **Kansas**

Sec. 2 (Blk. Twp.) 22 (Sur. Rge.) 14W Map No.

Operator **Sunray**

Well No. 4 Farm Keenan

Elev.	Location	SW	SE	ST
-------	----------	----	----	----

FIRST REPORT

330 Ft. From S Line SW

990 Ft. From E Line Quarter

1st. Report JAN 2 1952

Completion

Remarks


Anschutz Brig. - Contr.

Spudding Date **12-30-51**

Drlg. Data Smallwood Pool.

8th @ 344 WOC

J. E. TYRA

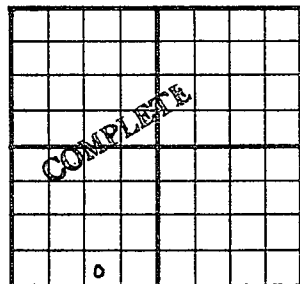County Stafford State KansasSec. 2 (Blk. 22) (Sur. 14W) Map No. 14WOperator SunrayWell No. 4 Farm KeenanElev. 1935 Location SW SE SW330 Ft. From S Line SW990 Ft. From E Line Quarter1st. Report Completion FEB 6 1952Remarks Smallwood PoolAnschutz Drlg. - Contr.Spudding Date 12-30-51Drlg. Data Oil well TD 37918" @ 344 Heeb. 3295 Br. lime 3419Lans. 3429 B KC 3660 Cong. 3689Viola 3696 Simp. 3730 Arb. 3786DST 3787-91 open 1 hr. Rec. 15' oil & mudTD 3791 5" @ 3787 CO to 3753 19/ 3547-53 test 3/4 boph 2000 A S/ 20 boph4 hr. Comp. 185 bopd

J. G. McGEHEE