

Company B & R Drlg

EAST

EDITORIAL

Sec. 2 Twp. 22 R. 14-W

Well No. #1 Wetig Farm

B & R Drlg Company

Wildcat Contractor

 Ft. from N. Line


330 Ft. from S. Line

330 Ft. from E. Line

 Ft. from W. Line

Magnolia Farmout

SE SE SE

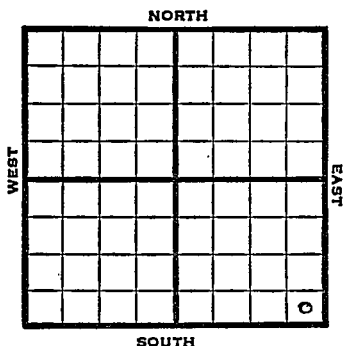

1950 Elev 1943' REPORT

2/15 Location

3/15 TD 3825'
8"@ 348'

Lans 3435'

Cong 3675'

Viola 3697'

Simp 3738'

D&A

Aband.

ABANDONED


Map No. _____ Sec. 2 Twp. 22 R. 14WWell No. 1 WetigB & R Drlg.

Company

Contractor

SE SE SE

SECTION PLAT

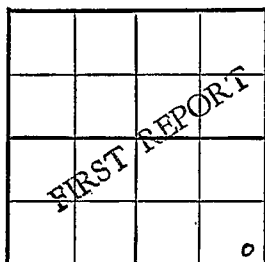 Ft. from N. Line330 Ft. from S. Line330 Ft. from E. Line Ft. from W. Line

Stafford County

Magnolia farmout

Location XRig up

Drilling and Remarks:

RECORD

Cased in., ft.Sand Gas Oil Total Depth

- - - PRODUCTION

1st 24 hrs. Nat. 1st 24 hrs. after shot Gas Cu. Ft.Dry Hole Abandoned

Date

FEB 15 1950

19

J. E. TYRA

Scout

Kansas

Map No. _____ Sec. 2 Twp. 22 R. 14WWell No. 1 Wetig

B & R Drlg. _____ Company _____

Contractor _____

SE SE SE


E. 1943
SECTION PLAT

_____ Ft. from N. Line

330 Ft. from S. Line330 Ft. from E. Line

_____ Ft. from W. Line

Stafford County

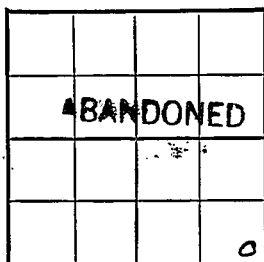

Location _____

Rig up _____

Drilling and Remarks:

8" @ 348
 Lens 3435
 Cong 3675
 Viola 3697
 Sings 3738
 D + A.

RECORD

Cased _____ in., _____ ft.

Sand _____

Gas _____

Oil _____

Total Depth 3825

PRODUCTION

1st 24 hrs. Nat. _____

1st 24 hrs. after shot _____

Gas _____ Cu. Ft.

Dry Hole _____

Abandoned _____

Date

MAY 15 1950

19

J. E. TYRA Scout