


Section 2 Township 22 Range 11W

Well No. #3 Wetig

Company Westgate-Greenland

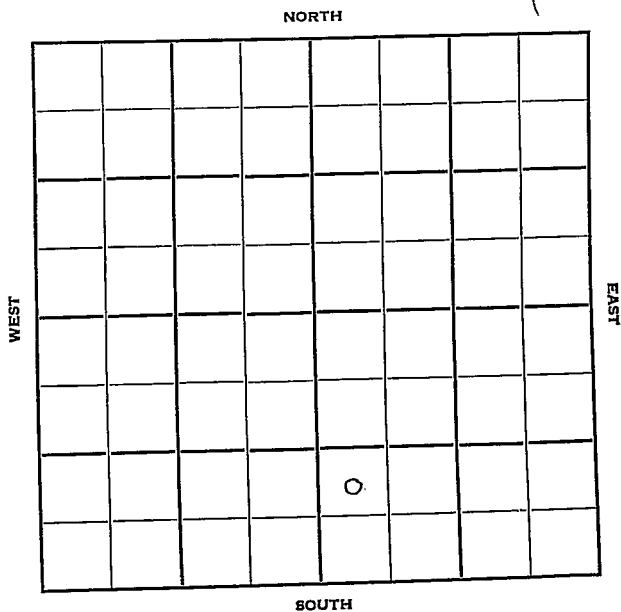

Stafford

KANSAS

Sec. 2 Twp. 22 R. 14 W

Well No. # 3 Wetig Farm

Westgate-Greenland Company

Jackson Drlg. Contractor

Small Wood Pool


Ft. from N. Line

990 Ft. from S. Line

Ft. from E. Line

330 Ft. from W. Line

NW SW SE

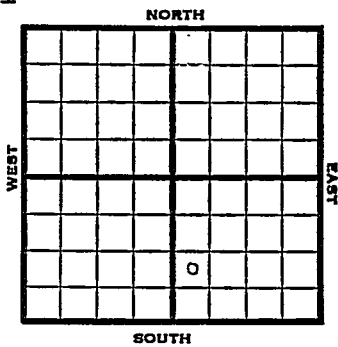

1951

Elev. 1934' REPORT

8/22

Spud 8-19-51
8" @ 323 WOC

10/17

8-19-51
 Oil Well TD 3818
 8" @ 323
 Heeb. 3190 Br. lime 3415
 KC 3426
 DST 3491-3503 open 1 hr.
 Rec. 30' mud
 DST 3543-57 open 1 hr.
 Rec. 600' gas 60' OCM
 DST 3563-94 open 1/2 hr.
 Rec. 6' mud
 DST 3603-23 open 1/2 hr.
 Rec. 30' MCSW
 B KC 3656 Viola 3689 Simp. 3722
 Arb. 3758
 TD 3818 5" @ 3817 116/ 3757-97
 1000 A wtr. PB 3580 66/ 3539-63
 1000 A S/ 60 BOPH
 Comp. 366 BOPD 4% Wtr.

COMPLETED

