

Section 2 Township 22 Range 14W

Well No. #4 Wetig

Company Westgate-Greenland

NORTH

						0	

WEST

EAST

SOUTH

Sec. 2 Twp. 22 R. 14 W

Well No. # 4 Wetig Farm

Westgate-Greenland Company

Contractor

Smallwood Pool


330 Ft. from N. Line

Ft. from S. Line

990 Ft. from E. Line

Ft. from W. Line

NW NE SE

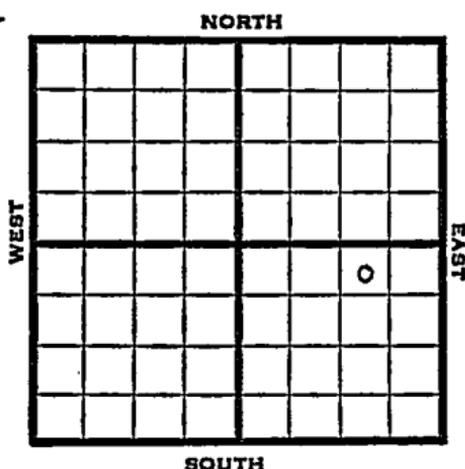

1951

Elev. 1935' REPORT

9/5

Spud 9-2-51

8" @ 339

Drlg. 570'

10/17

Spud 9-2-51

Oil Well TD 3803'

8" @ 339

Heeb. 3283

Br. line 3406

Ians. 3417

DST 3478-94 open 1 hr.

Rec. 1350' clean oil

DST 3535-48 open 1 hr.

Rec. 2040' clean oil

B KC 3649 Simp. 3708

Viola 3670 Arb. 3752

DST 3752-74 open 1 hr.

Rec. 690' clean oil TD 3803

5" @ 3802

48/ 3533-48 FU 500' oil 200 A

F/ 50 BOPH Comp. BHB 1601 BOPD

COMPLETED

3752
1935
1817

