


Section 2 Township 22 Range 11W

Well No. #5 Wetig

Company Westgate-Greenland

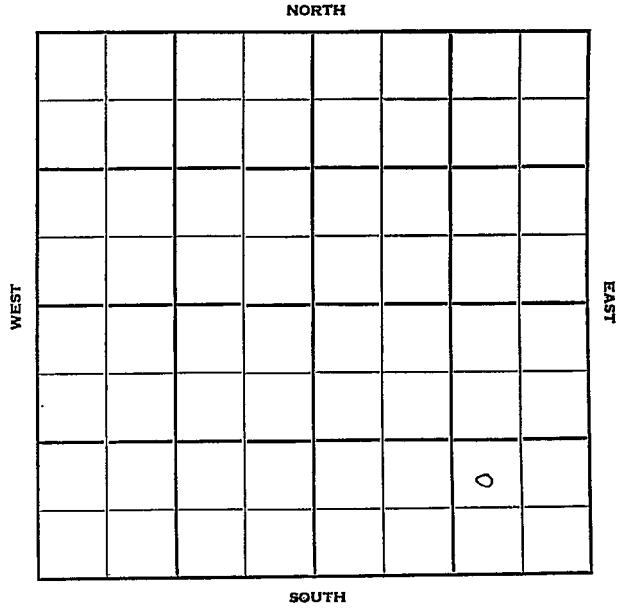

Sec. 2 Twp. 22 R. 14 W

Well No. # 5 Wetig Farm

Westgate-Greenland Company

Jackson Contractor


Small Wood Pool

_____ Ft. from N. Line

990 Ft. from S. Line

990 Ft. from E. Line

_____ Ft. from W. Line

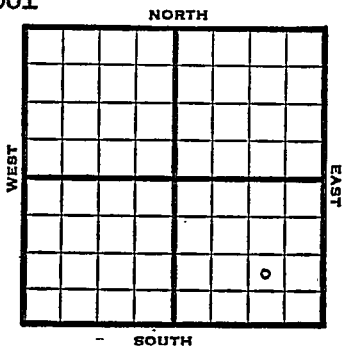

NW SE SE

1951

Elev. 1938' REPORT

9/19

Spud 9-15-51
8" @ 334 Anhy 813'
Drlg. 1460'

1952

2/6
2/13

TD 4165 5" @ 3915 DP
Spud 9-15-51
SWD Well TD 4165
8" @ 334 Anhy 813
Lans. 3440
DST 3504-19 opn 1 hr Rec. 65' mud
DST 3557-71 opn 1 hr. Rec. 5' mud
DST 3614-28 opn 1 hr. Rec. 35' mud
& sw Viola 3706 Simp 3746
Arb. 3804 TD 4165 5" @ 3915
Comp. for SWD well

ABANDONED

