


Section 2 Township 22 Range 11W

Well No. #6 Wetig

Company Westgate-Greenland

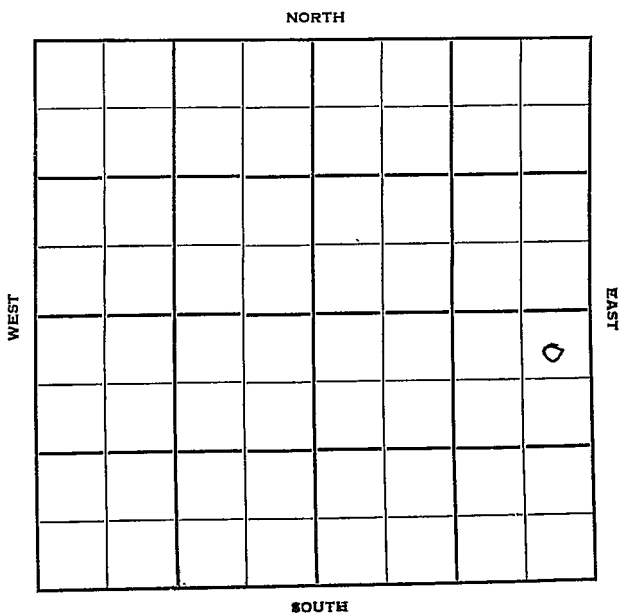

Stafford



Sec. 2 Twp. 22 R. 11W **KANSAS**

Well No. #6 Wetig Farm

Westgate-Greenland Company

Westgate-Greenland Contractor


330 Ft. from N. Line

\_\_\_\_\_ Ft. from S. Line

330 Ft. from E. Line

\_\_\_\_\_ Ft. from W. Line

SE  $\frac{1}{4}$  NE NE SE

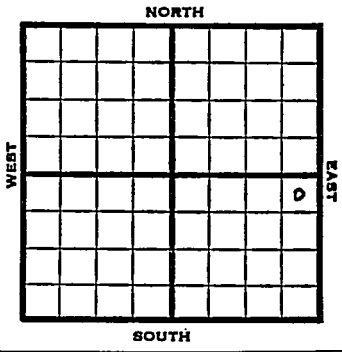

1952 Elev. 1933' REPORT

11/12 Spud 11-6-52  
 10 @ 337'  
 Anhy 810'  
 Drlg. 2228'

*3842  
 19.3  
 11/19*

11/19 Spud 11-6-52  
 D&A  
 TD 3865'  
 10" @ 337  
 Anhy 810, Heeb. 3290, Br. Lime  
 3417, Lans 3425  
 DST 3545-63, opn 1 hr., rec.  
 8' mud, 0#  
 Cong. 3698, Viola 3724, Simp  
 3793, Arb. 3842  
 TD 3865  
 D&A

**ABANDONED**

County Stafford State Kansas  
 Sec. 2 (Blk. 22 (Sur. 14W Map No.  
 (Twp.) (Rge.)  
 Operator Westgate-Greenland  
 Well No. 6 Farm Wetig  
 Elev. Location NE NE SE


330 Ft. From N Line SE  
330 Ft. From E Line Quarter  
 Ist. Report NOV 12 1952  
 Completion \_\_\_\_\_  
 Remarks Westgate-Greenland - Cont  
 Spudding Date 11-6-52

Drlg. Data  
10" @ 337 Anhy 810 drlg. 2228

J. G. McGEHEE

